

STATE OF KANSAS
STATE CORPORATION COMMISSION

WELL PLUGGING RECORD

Give All Information Completely
Make Required Affidavit
Mail or Deliver Report to:
Conservation Division
State Corporation Commission
800 Bitting Building
Wichita, Kansas

Sheridan County. Sec. 2 Twp. 7 Rge. (E) 27 (W)

Location as "NE/CNW/SW" or footage from lines SW SW NE

Lease Owner Fred B. Anschutz

Lease Name Sniffen Well No. 1

Office Address 1019 Central Building, Wichita, Kansas

Character of Well (completed as Oil, Gas or Dry Hole) Dry

Date well completed 9-3 19 56

Application for plugging filed 9-15 19 56

Application for plugging approved 9-17 19 56


Plugging commenced 9-21 19 56

Plugging completed 9-29 19 56

Reason for abandonment of well or producing formation Non-commercial

If a producing well is abandoned, date of last production 19

Was permission obtained from the Conservation Division or its agents before plugging was commenced? Yes

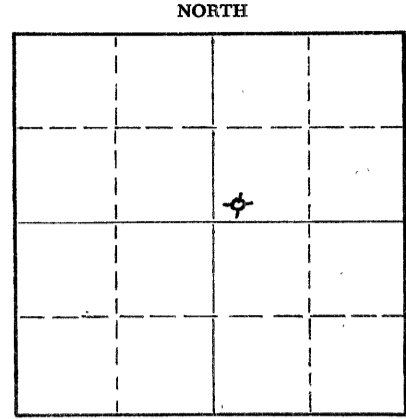

Locate well correctly on above
Section Plat

Name of Conservation Agent who supervised plugging of this well Eldon Pftty

Producing formation Lansing-K. C. Depth to top 3853 Bottom 3897 FB Total Depth of Well 4080 Feet

Show depth and thickness of all water, oil and gas formations.

OIL, GAS OR WATER RECORDS

7/11/2005 CASING RECORD

FORMATION	CONTENT	FROM	TO	SIZE	PUT IN ^{HGE} _{KCC}	PULLED OUT
<u>Lansing-K. C.</u>	<u>Small Show</u>	<u>3840</u>		<u>8 5/8</u>	<u>155</u>	<u>None</u>
	<u>Trace Hvy. Oil</u>	<u>3856</u>		<u>5 1/2</u>	<u>3910</u>	<u>2400</u>
	<u>Scum of Oil</u>	<u>3856</u>	<u>3857</u>			
	<u>" " "</u>	<u>3857</u>	<u>3861</u>			
	<u>" " "</u>	<u>3858</u>				
	<u>" " "</u>	<u>3859</u>				
	<u>" " "</u>	<u>3860</u>				
	<u>Water</u>	<u>3862</u>	<u>3866</u>			

Describe in detail the manner in which the well was plugged, indicating where the mud fluid was placed and the method or methods used in introducing it into the hole. If cement or other plugs were used, state the character of same and depth placed, from _____ feet to _____ feet for each plug set.

Plugged back with sand 3830', dumped 4 sacks cement, mudded hole to 350', set 10' rock bridge, dumped 30 sacks cement, mudded hole to 35', set rock bridge, dumped 10 sacks cement to top of surface pipe.

(If additional description is necessary, use BACK of this sheet)

Name of Plugging Contractor E & L Casing Pulling Company
Address Great Bend, Kansas

STATE OF KANSAS, COUNTY OF SEDGWICK, ss.

John W. Ritchey (employee of owner) or (owner or operator) of the above-described well, being first duly sworn on oath, says: That I have knowledge of the facts, statements, and matters herein contained and the log of the above-described well as filed and that the same are true and correct. So help me God.

(Signature) John W. Ritchey
(Address) _____

SUBSCRIBED AND SWORN TO before me this 11 day of October 19 56

My commission expires 23 April 1958

Maree C. Murphy
Notary Public.

