

CARD MUST BE TYPED

State of Kansas

CARD MUST BE SIGNED

NOTICE OF INTENTION TO DRILL

(see rules on reverse side)

Starting Date 6/ 24/86
month day year

API Number 15— 059-2471-00-00
SW SE NE 34 15 21 East
2805 Sec..... Twp..... S, Rg..... West
1155 Ft. from South Line of Section
Ft. from East Line of Section

OPERATOR: License # 4987
Name Ronco, Inc.
Address 6901 Mission Road
City/State/Zip Prairie Village, KS 66208
Contact Person John Roney
Phone (913) 362-7200

(Note: Locate well on Section Plat on reverse side)
165
Nearest lease or unit boundary line feet

CONTRACTOR: License # 5335
Name Hawkeye Drilling Co.
City/State Wellsville, Kansas 66092

County..... Franklin
Lease Name..... Courter Well # 4

Well Drilled For: Well Class: Type Equipment:
 Oil SWD Infield Mud Rotary
 Gas Inj Pool Ext. Air Rotary
 OWWO Expl Wildcat Cable

Ground surface elevation n/a feet MSL
Domestic well within 330 feet: yes no
Municipal well within one mile: yes no
Surface pipe by Alternate: 1 2
Depth to bottom of fresh water 106
Depth to bottom of usable water 200
Surface pipe planned to be set 20
Projected Total Depth 750 feet
Formation..... Squirrel.....

If OWWO: old well info as follows:
Operator
Well Name
Comp Date Old Total Depth.....

I certify that well will comply with K.S.A. 55-101, et seq., plus eventually plugging hole to KCC specifications.

Date 6/23/86 Signature of Operator or Agent Melanne Corviss Title..... As. Agent.....


For KCC Use:
Conductor Pipe Required feet; Minimum Surface Pipe Required feet per Alg
This Authorization Expires 12-23-86 Approved By 6-23-86

Must be filed with the K.C.C. five (5) days prior to commencing well
 This card void if drilling not started within six (6) months of date received by K.C.C.

Important procedures to follow:

1. Notify District office before setting surface casing.
2. Set surface casing by circulating cement to the top.
3. File completion forms ACO-1 with K.C.C. within 90 days of well completion, following instructions on ACO-1, side 1, and including copies of wireline logs.
4. Notify District office 48 hours prior to old well workover or re-entry.
5. Prior to filing Intent, prepare a proposed plugging plan in case well is D & A, then obtain approval of plan when calling district office prior to setting surface pipe.
6. Submit plugging report (CP-4) to K.C.C. after plugging is completed.
7. Obtain an approved injection docket number before disposing of salt water.
8. Notify K.C.C. within 10 days when injection commences or terminates.
9. If an alternate 2 completion, cement in the production pipe from below any usable water to surface within 120 days of spud date.

**A Regular Section of Land
 1 Mile = 5,280 Ft.**

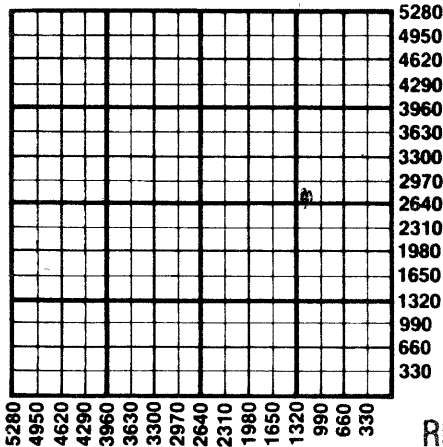

RECEIVED
 STATE CORPORATION COMMISSION

JUN 23 1986

6-23-86

CONSERVATION DIVISION
 Wichita, Kansas

State Corporation Commission of Kansas
 Conservation Division
 200 Colorado Derby Building
 Wichita, Kansas 67202
 (316) 263-3238