

CARD MUST BE TYPED

State of Kansas

CARD MUST BE SIGNED

NOTICE OF INTENTION TO DRILL

(see rules on reverse side)

Starting Date 7/22/86
month day year

API Number 15- 059-24177-00-00
X East

OPERATOR: License # 4987 App. Name Ranco, Inc.
Address 6901 Mission Rd.
City/State/Zip Prairie Village, KS 66208
Contact Person John Roney
Phone 913-362-7200

SW SE. NE. Sec. 34 Twp. 18 S Rg. 21 E
..... 31.35 Ft. from South Line of Section
..... 49.5 Ft. from East Line of Section

(Note: Locate well on Section Plat on reverse side)

CONTRACTOR: License # 5335 Name Hawkeye Drilling
City/State Wellsville, Kansas

Nearest lease or unit boundary line 49.5 feet
County Franklin

Well Drilled For: Well Class: Type Equipment:
 Oil SWD Oilfield Mud Rotary
 Gas Inj Pool Ext. Air Rotary
 OWWO Expl Wildcat Cable

Lease Name Courter Well # 7 ..
Ground surface elevation n/a feet MSL
Domestic well within 330 feet: yes no
Municipal well within one mile: yes no

If OWWO: old well info as follows:
Operator
Well Name
Comp Date Old Total Depth

Depth to bottom of fresh water 106
Depth to bottom of usable water 200
Surface pipe by Alternate: 1 2 X X
Surface pipe planned to be set 20
Conductor pipe required n/a
Projected Total Depth 700 feet
Formation Squirrel

I certify that well will comply with K.S.A. 55-101, et seq., plus eventually plugging hole to KCC specifications.

Date 7/21/86 Signature of Operator or Agent Clairie Durham Title as agent

For KCC Use:
Conductor Pipe Required feet; Minimum Surface Pipe Required 20 feet per Alt. #2
This Authorization Expires 1-21-87 Approved By 7-21-86


PC+KCC

Must be filed with the K.C.C. five (5) days prior to commencing well
 This card void if drilling not started within six (6) months of date received by K.C.C.

Important procedures to follow:

1. Notify District office before setting surface casing.
2. Set surface casing by circulating cement to the top.
3. File completion forms ACO-1 with K.C.C. within 90 days of well completion, following instructions on ACO-1, side 1, and including copies of wireline logs.
4. Notify District office 48 hours prior to old well workover or re-entry.
5. Prior to filing Intent, prepare a proposed plugging plan in case well is D & A, then obtain approval of plan when calling district office prior to setting surface pipe.
6. Submit plugging report (CP-4) to K. C. C. after plugging is completed.
7. Obtain an approved injection docket number before disposing of salt water.
8. Notify K.C.C. within 10 days when injection commences or terminates.
9. If an alternate 2 completion, cement in the production pipe from below any usable water to surface within 120 days of spud date.

A Regular Section of Land
1 Mile = 5,280 Ft.

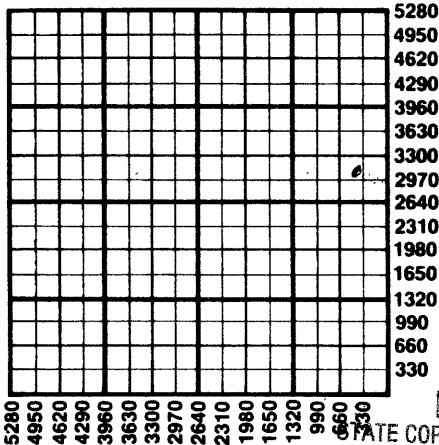

RECEIVED
 STATE CORPORATION COMMISSION

JUL 21 1986

CONSERVATION DIVISION
 Wichita, Kansas

7-21-86

State Corporation Commission of Kansas
 Conservation Division
 200 Colorado Derby Building
 Wichita, Kansas 67202
 (316) 263-3238