

CARD MUST BE TYPED

State of Kansas

CARD MUST BE SIGNED

NOTICE OF INTENTION TO DRILL

(see rules on reverse side)

Starting Date 9 15 86
 month day year

OPERATOR: License # 5666
Name Finch's Drilling, Inc
Address RR 2 Box 125
City/State/Zip Ottawa, KS 66067
Contact Person Gardner C. Finch
Phone 913-878-3332

CONTRACTOR: License # 5666
Name Company Tools
City/State

Well Drilled For: Well Class: Type Equipment:
 Oil SWD Infield Mud Rotary
 Gas Inj Pool Ext. Air Rotary
 OWWO Expl Wildcat Cable

If OWWO: old well info as follows:
Operator
Well Name
Comp Date Old Total Depth

I certify that well will comply with K.S.A. 55-101, et seq., plus eventually plugging hole to KCC specifications.

_____ cementing will be done immediately upon setting production casing.
Date .. 9-4-86 Signature of Operator or Agent *Gardner C. Finch* Title *Pres*

For KCC Use:

Conductor Pipe Required feet; Minimum Surface Pipe Required 20 feet per Alt. *RFD*
This Authorization Expires 3-8-87 Approved By 9-8-86

API Number 15- ~~0059-24186~~ -00-00
NE SE₄ Sec. 34 Twp. 15 S, Rg. 21E East
 1815 Ft. from South Line of Section
 495 Ft. from East Line of Section

(Note: Locate well on Section Plat on reverse side)


Nearest lease or unit boundary line 495 feet
County Franklin
Lease Name Johnson Well # 24
Ground surface elevation feet MSL
Domestic well within 330 feet: yes no
Municipal well within one mile: yes no
Surface pipe by Alternate: 1 - 2
Depth to bottom of fresh water 200'
Depth to bottom of usable water 200'
Surface pipe planned to be set 21'
Projected Total Depth 750 feet
Formation Squirrel

Must be filed with the K.C.C. five (5) days prior to commencing well
This card void if drilling not started within six (6) months of date received by K.C.C.

Important procedures to follow:

1. Notify District office before setting surface casing.
2. Set surface casing by circulating cement to the top.
3. File completion forms ACO-1 with K.C.C. within 90 days of well completion, following instructions on ACO-1, side 1, and including copies of wireline logs.
4. Notify District office 48 hours prior to old well workover or re-entry.
5. Prior to filing Intent, prepare a proposed plugging plan in case well is D & A, then obtain approval of plan when calling district office prior to setting surface pipe.
6. Submit plugging report (CP-4) to K.C.C. after plugging is completed.
7. Obtain an approved injection docket number before disposing of salt water.
8. Notify K.C.C. within 10 days when injection commences or terminates.
9. If an alternate 2 completion, cement in the production pipe from below any usable water to surface within 120 days of spud date.

**A Regular Section of Land
1 Mile = 5,280 Ft.**

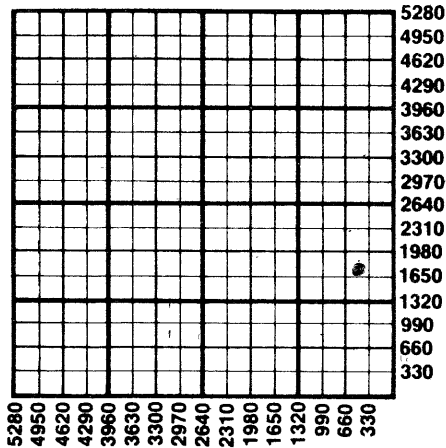

8 1988
9-8-86

State Corporation Commission of Kansas
Conservation Division
200 Colorado Derby Building
Wichita, Kansas 67202
(316) 263-3238