

CARD MUST BE TYPED

State of Kansas

CARD MUST BE SIGNED

NOTICE OF INTENTION TO DRILL

(see rules on reverse side)

CORRECTED INTENT

10-10-85

Starting Date 9 28 83
month day year

API Number 15- 121-25,945 - 00-00

(*) OPERATOR: License # 6293
 Name .. Continental Exploration, Inc..
 Address .. 7315 Frontage Road, #110..
 City/State/Zip .. Shawnee Mission, KS. 66204..
 Contact Person .. William P. Moore, III..
 Phone .. 913-384-2234.....

* SW. SE. NW. Sec. 29. Twp. 17 S, Rg. 22... ☒ East
 * 3,140 Ft. from South Line of Section
 * 3,830 Ft. from East Line of Section

(Note: Locate well on Section Plat on reverse side)

CONTRACTOR: License # 5725
 Name Westover Petroleum
 City/State Rockville, New York

* Nearest lease or unit boundary line 510 feet
 County Miami

Lease Name .. Feebeck .. Well #. 3 ..

Ground surface elevation .. 920 feet MSL

Domestic well within 330 feet: yes ☒ noMunicipal well within one mile: yes ☒ noSurface pipe by Alternate: 1 ☐ 2 ☒

Depth to bottom of fresh water 43

Depth to bottom of usable water 200

Surface pipe planned to be set 20

Projected Total Depth 750 feet

Formation Wayside

Well Drilled For: Well Class: Type Equipment:
☒ Oil ☐ SWD ☒ Infield ☒ Mud Rotary
☐ Gas ☐ Inj ☐ Pool Ext. ☐ Air Rotary
☐ OWWO ☐ Expl ☐ Wildcat ☐ Cable

If OWWO: old well info as follows:

Operator

Well Name

Comp Date Old Total Depth

I certify that well will comply with K.S.A. 55-101, et seq., plus eventually plugging hole to KCC specifications.

..... cementing will be done immediately upon setting production casing.

Date .. 9/30/85 Signature of Operator or Agent Title .. President ..

For KCC Use:

Conductor Pipe Required feet; Minimum Surface Pipe Required feet per Alt. 1 2

This Authorization Expires .. 3-28-84 Approved By .. 9-28-83


2145 FNL
 Xmas Ballou Oil Well Serv. 1534 FNL

Must be filed with the K.C.C. five (5) days prior to commencing well
This card void if drilling not started within six (6) months of date received by K.C.C.

Important procedures to follow:

1. Notify District office before setting surface casing.
2. Set surface casing by circulating cement to the top.
3. File completion forms ACO-1 with K.C.C. within 90 days of well completion, following instructions on ACO-1, side 1, and including copies of wireline logs.
4. Notify District office 48 hours prior to old well workover or re-entry.
5. Prior to filing Intent, prepare a proposed plugging plan in case well is D & A, then obtain approval of plan when calling district office prior to setting surface pipe.
6. Submit plugging report (CP-4) to K.C.C. after plugging is completed.
7. Obtain an approved injection docket number before disposing of salt water.
8. Notify K.C.C. within 10 days when injection commences or terminates.

A Regular Section of Land
1 Mile = 5,280 Ft.

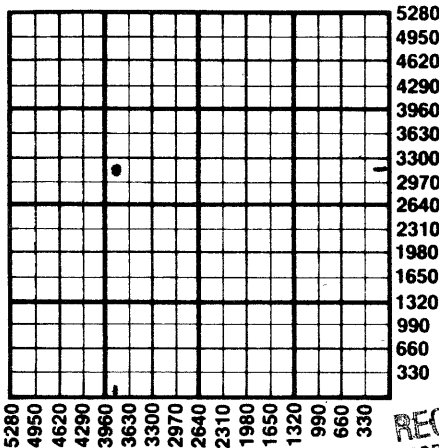

RECEIVED
STATE CORPORATION COMMISSION

OCT 10 1985

CONSERVATION DIVISION
Wichita, Kansas

If an alternate 2 completion, cement in the production pipe from below any usable water to surface within 120 days of spud date.

State Corporation Commission of Kansas
Conservation Division
200 Colorado Derby Building
Wichita, Kansas 67202
(316) 263-3238