

CARD MUST BE TYPED

State of Kansas

CARD MUST BE SIGNED

### NOTICE OF INTENTION TO DRILL

(see rules on reverse side)

**CORRECTED INTENT**

*10-10-85*

Starting Date ..... 10/4/84 .....  
month day year

API Number 15— 121-26,374-00-00

OPERATOR: License # 6293

NE SW NW 29 Sec. Twp. 17 S, Rg. 22  East

Name Continental Exploration, Inc.

..... 3,755 ..... Ft. from South Line of Section

Address 7315 Frontage Rd., #110

\* 4,110 ..... Ft. from East Line of Section

City/State/Zip Shawnee Mission, KS 66204

(Note: Locate well on Section Plat on reverse side)

Contact Person William P. Moore, III

Phone 913-384-2234

CONTRACTOR: License # 5938

\* Nearest lease or unit boundary line 200 ..... feet

Name C. & M. Drilling

County Miami

City/State Paola, KS

Lease Name Feebeck #1 Well # 24

Well Drilled For: Well Class: Type Equipment:

Ground surface elevation 960 ..... feet MSL

Oil  SWD  Infield  Mud Rotary  
 Gas  Inj  Pool Ext.  Air Rotary  
 OWWO  Expl  Wildcat  Cable

Domestic well within 330 feet:  yes  no

If OWWO: old well info as follows:

Municipal well within one mile:  yes  no

Operator .....

Surface pipe by Alternate: 1 2 X

Well Name .....

Depth to bottom of fresh water ..... 43 .....

Comp Date ..... Old Total Depth .....

Depth to bottom of usable water ..... 200 .....

I certify that well will comply with K.S.A. 55-101, et seq., plus eventually plugging hole to KCC specifications.

                     cementing will be done immediately upon setting production casing. \* was: Baillon Oil Well Serv. SE 1/4 1155-FSL

Date 10/7/85 Signature of Operator or Agent [Signature] Title President #14 1436 FBL

For KCC Use:

Conductor Pipe Required ..... feet; Minimum Surface Pipe Required ..... feet per Alt. 1 2


This Authorization Expires 4-4-85 Approved By 10-4-84

Must be filed with the K.C.C. five (5) days prior to commencing well  
 This card void if drilling not started within six (6) months of date received by K.C.C.

**Important procedures to follow:**

1. Notify District office before setting surface casing.
2. Set surface casing by circulating cement to the top.
3. File completion forms ACO-1 with K.C.C. within 90 days of well completion, following instructions on ACO-1, side 1, and including copies of wireline logs.
4. Notify District office 48 hours prior to old well workover or re-entry.
5. Prior to filing Intent, prepare a proposed plugging plan in case well is D & A, then obtain approval of plan when calling district office prior to setting surface pipe.
6. Submit plugging report (CP-4) to K.C.C. after plugging is completed.
7. Obtain an approved injection docket number before disposing of salt water.
8. Notify K.C.C. within 10 days when injection commences or terminates.

**A Regular Section of Land**  
**1 Mile = 5,280 Ft.**

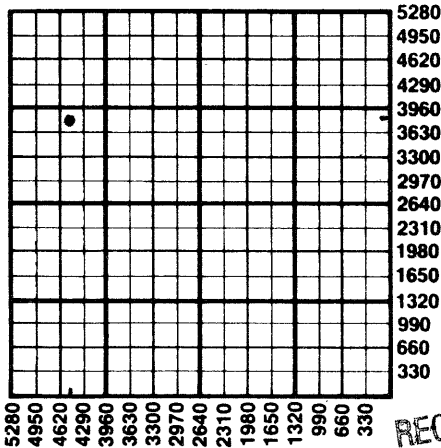

**RECEIVED**  
 STATE CORPORATION COMMISSION

**OCT 10 1985**

CONSERVATION DIVISION  
 Wichita, Kansas

of an alternate 2 completion, cement in the production pipe from below any usable water to surface within 120 days of spud date.

State Corporation Commission of Kansas  
 Conservation Division  
 200 Colorado Derby Building  
 Wichita, Kansas 67202  
 (316) 263-3238