

CARD MUST BE TYPED

State of Kansas

CARD MUST BE SIGNED

NOTICE OF INTENTION TO DRILL

(see rules on reverse side)

CORRECTED INTENT

10-1085

Starting Date 10/04/84 month day year

API Number 15— 121-26,375-00-00

(*) OPERATOR: License # ... 6293
Name Continental Exploration, Inc.
Address ... 7315 Frontage Road, #110
City/State/Zip ... Shawnee Mission, KS 66204
Contact Person ... William P. Moore, III
Phone ... 913-384-2234

(*) X East
NW SE NW Sec. 29. Twp. 17... S, Rg. 22... West
..... 3,480 Ft. from South Line of Section
(*) 3,775 Ft. from East Line of Section
(Note: Locate well on Section Plat on reverse side)

CONTRACTOR: License # ... 5938
Name ... C. & M. Drilling Co.
City/State ... Paola, KS 66071

* Nearest lease or unit boundary line ... 490 feet
County ... Miami
Lease Name ... Feebeck #1 ... Well # ... 36
Ground surface elevation ... 930 feet MSL
Domestic well within 330 feet: _____ yes X no
Municipal well within one mile: _____ yes X no
Surface pipe by Alternate: 1 2 X 1
Depth to bottom of fresh water ... 43
Depth to bottom of usable water ... 2.0
Surface pipe planned to be set ... 2.0
Projected Total Depth ... 630 feet
Formation ... Wayside

Well Drilled For: Well Class: Type Equipment:
X Oil _____ SWD X Infield X Mud Rotary
_____ Gas _____ Inj _____ Pool Ext. _____ Air Rotary
_____ OWWO _____ Expl _____ Wildcat _____ Cable

If OWWO: old well info as follows:
Operator
Well Name
Comp Date Old Total Depth

I certify that well will comply with K.S.A. 55-101, et seq., plus eventually plugging hole to KCC specifications. *Gas: Below oil well - Sedv.*
_____ cementing will be done immediately upon setting production casing. *SE 4 825 FSL 1766 FEL*
Date ... 9/27/85 ... Signature of Operator or Agent *[Signature]* Title ... President # 15


For KCC Use:
Conductor Pipe Required feet; Minimum Surface Pipe Required feet per Alt. 1 2
This Authorization Expires ... 4-4-85 Approved By ... 10-4-84

Must be filed with the K.C.C. five (5) days prior to commencing well
This card void if drilling not started within six (6) months of date received by K.C.C.

Important procedures to follow:

1. Notify District office before setting surface casing.
2. Set surface casing by circulating cement to the top.
3. File completion forms ACO-1 with K.C.C. within 90 days of well completion, following instructions on ACO-1, side 1, and including copies of wireline logs.
4. Notify District office 48 hours prior to old well workover or re-entry.
5. Prior to filing Intent, prepare a proposed plugging plan in case well is D & A, then obtain approval of plan when calling district office prior to setting surface pipe.
6. Submit plugging report (CP-4) to K.C.C. after plugging is completed.
7. Obtain an approved injection docket number before disposing of salt water.
8. Notify K.C.C. within 10 days when injection commences or terminates.
9. If an alternate 2 completion, cement in the production pipe from below any usable water to surface within 120 days of spud date.

A Regular Section of Land
1 Mile = 5,280 Ft.

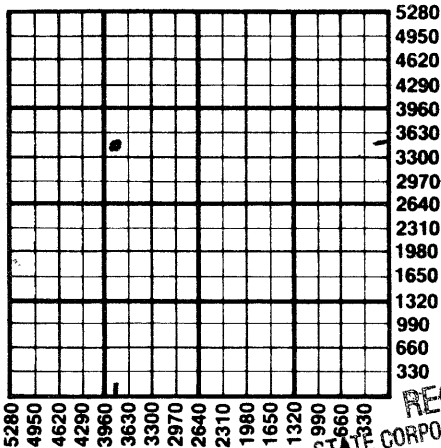

RECEIVED
STATE CORPORATION COMMISSION

OCT 10 1985

CONSERVATION DIVISION
Wichita, Kansas

State Corporation Commission of Kansas
Conservation Division
200 Colorado Derby Building
Wichita, Kansas 67202
(316) 263-3238