

CARD MUST BE TYPED

State of Kansas
NOTICE OF INTENTION TO DRILL
(see rules on reverse side)

CARD MUST BE SIGNED

Collection
10-10-85

Starting Date 10/4/84
month day year

API Number 15- 121-26,376- 00-00

(*) OPERATOR: License # 6293
Name Continental Exploration, Inc.
Address 7315 Frontage Road, #110
City/State/Zip Shawnee Mission, KS 66204
Contact Person William P. Moore, III
Phone 913-384-2234

(*) NE. SW. NW. Sec. 29. Twp. 17. S, Rg. 22. ___ East
..... 3,495 Ft. from South Line of Section
..... 4,410 Ft. from East Line of Section
(Note: Locate well on Section Plat on reverse side)

CONTRACTOR: License # 5938
Name C & M Drilling Co.
City/State Paola, Ks

* Nearest lease or unit boundary line (5) 475 feet
County Miami
Lease Name Feebeck #1 Well # 34 (5)
Ground surface elevation 980 feet MSL
Domestic well within 330 feet: ___ yes no
Municipal well within one mile: ___ yes no
Surface pipe by Alternate: 1 2 ___
Depth to bottom of fresh water 43
Depth to bottom of usable water 200
Surface pipe planned to be set 20
Projected Total Depth 630 feet
Formation Wayside

Well Drilled For: Well Class: Type Equipment:
___ Oil ___ SWD Infield Mud Rotary
___ Gas Inj ___ Pool Ext. ___ Air Rotary
___ OWWO ___ Expl ___ Wildcat ___ Cable

If OWWO: old well info as follows:
Operator
Well Name
Comp Date Old Total Depth

I certify that well will comply with K.S.A. 55-101, et seq., plus eventually plugging hole to KCC specifications.
cementing will be done immediately upon setting production casing. *Kwas, Ballou oil well serv SE/4*
Date 10/07/85 Signature of Operator or Agent Title President *#16 825 FSL 1106 FSL*


For KCC Use:
Conductor Pipe Required feet; Minimum Surface Pipe Required feet per Alt. 1 2
This Authorization Expires 4-4-85 Approved By 10-4-84

Must be filed with the K.C.C. five (5) days prior to commencing well
 This card void if drilling not started within six (6) months of date received by K.C.C.

Important procedures to follow:

1. Notify District office before setting surface casing.
2. Set surface casing by circulating cement to the top.
3. File completion forms ACO-1 with K.C.C. within 90 days of well completion, following instructions on ACO-1, side 1, and including copies of wireline logs.
4. Notify District office 48 hours prior to old well workover or re-entry.
5. Prior to filing Intent, prepare a proposed plugging plan in case well is D & A, then obtain approval of plan when calling district office prior to setting surface pipe.
6. Submit plugging report (CP-4) to K.C.C. after plugging is completed.
7. Obtain an approved injection docket number before disposing of salt water.
8. Notify K.C.C. within 10 days when injection commences or terminates.

A Regular Section of Land
 1 Mile = 5,280 Ft.

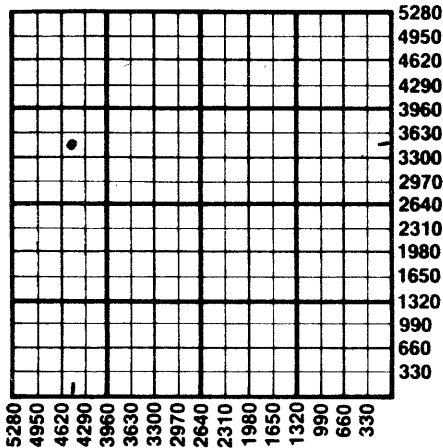

RECEIVED
 STATE CORPORATION COMMISSION

OCT 10 1985

CONSERVATION DIVISION
 Wichita, Kansas

9. If an alternate 2 completion, cement in the production pipe from any usable water to surface within 120 days of spud date.

State Corporation Commission of Kansas
 Conservation Division
 200 Colorado Derby Building
 Wichita, Kansas 67202
 (316) 263-3238