

CARD MUST BE TYPED

STATE OF KANSAS
NOTICE OF INTENTION TO DRILL
(see rules on reverse side)

****CORRECTED CARD****

CARD MUST BE SIGNED

11-27-84

Starting Date: 11 16 84
month day year

API Number 15-121-26-434-00-00
LOCATIONS & WELL NO.
121-26-434

OPERATOR: License # 6293
Name Continental Exploration, Inc.
Address 7315 Frontage Road, #110
City/State/Zip Shawnee Mission, KS 66204
Contact Person Wm. P. Moore, III
Phone 913-384-2234

*NW 29 17 22 East
(location) Sec Twp S. Rge West

**2815
**4785 Ft North from Southeast Corner of Section
Ft West from Southeast Corner of Section
(Note: Locate well on Section Plat on reverse side)

CONTRACTOR: License # 5956
Name Gary Jackson Drilling Co.
City/State Bronson, KS 66716

Nearest lease or unit boundary line 495 feet.
County Miami
Lease Name FEEBECK #1 * Well# 53***

Well Drilled For: Well Class: Type Equipment:
 Oil Swd Infield Mud Rotary
 Gas Inj Pool Ext. Air Rotary
 OWWO Expl Wildcat Cable

Domestic well within 330 feet: yes no
Municipal well within one mile: yes no

If OWWO: old well info as follows:

Operator
Well Name
Comp Date Old Total Depth
Projected Total Depth 1000 feet
Projected Formation at TD
Expected Producing Formations

Depth to Bottom of fresh water None feet
Lowest usable water formation
Depth to Bottom of usable water 200 feet
Surface pipe by Alternate: 1 2
Surface pipe to be set 20 feet
Conductor pipe if any required None feet
Ground surface elevation feet MSL

This Authorization Expires 5-15-85
Approved By 11-15-84

I certify that we will comply with K.S.A. 55-101, et seq., plus eventually plugging hole to K.C.C. specifications.

*Was SW 1825' N of SE C Sec.
*Was 5115' W of SE C Sec.
President ***Was 82


Date 11/20/84 Signature of Operator or Agent

Title

**Must be filed with the K.C.C. five (5) days prior to commencing well
This card void if drilling not started within six (6) months of date received by K.C.C.**

Important procedures to follow :

**A Regular Section of Land
1 Mile = 5,280 Ft.**

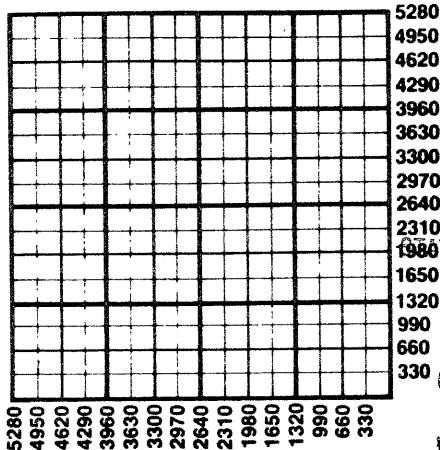

1. Notify District office before setting surface casing.
2. Set surface casing by circulating cement to the top.
3. File completion forms ACO-1 with K.C.C. within 90 days of well completion, following instructions on ACO-1, side 1, and including copies of wireline logs.
4. Notify District office 48 hours prior to old well workover or re-entry.
5. Prior to plugging, prepare a plugging plan, then obtain agreement from the appropriate district office for an approved plugging plan.
6. Submit plugging report (CP-4) to K.C.C. after plugging is completed.
7. Obtain an approved injection docket number before disposing of salt water.
8. Notify K.C.C. within 10 days when injection commences or terminates.
9. If an alternate 2 completion, cement in the production pipe from below any usable water to surface within 120 days of spud date.

RECEIVED
STATE CORPORATION COMMISSION
NOV 26 1984
CONSERVATION DIVISION
Wichita, Kansas
11-26-84

**State Corporation Commission of Kansas
Conservation Division
200 Colorado Derby Building
Wichita, Kansas 67202
(316) 263-3238**