

CARD MUST BE TYPED

State of Kansas

CARD MUST BE SIGNED

NOTICE OF INTENTION TO DRILL

(see rules on reverse side)

Starting Date Nov 30 1985
month day year

API Number 15— 163-22,833-0000

OPERATOR: License # 8449
Name McNames & Patterson
Address P.O. Box 20058
City/State/Zip Wichita, Ks 67208
Contact Person Gary Patterson
Phone 733-5750

W/2 NE NE Sec. 18 Twp. 8S S, Rg. 18 W — East
4620 — West
990 Ft. from South Line of Section
Ft. from East Line of Section

(Note: Locate well on Section Plat on reverse side)

CONTRACTOR: License # 365 5655
Name Shields Drlg Co., Inc.
City/State Russell, Ks

Nearest lease or unit boundary line 660 feet
County Rooks
Lease Name Bouchey Well # #1
Ground surface elevation 1965 feet MSL

Well Drilled For: Well Class: Type Equipment:
 Oil SWD Infield Mud Rotary
 Gas Inj Pool Ext. Air Rotary
 OWWO Expl Wildcat Cable

Domestic well within 330 feet: yes no
Municipal well within one mile: yes no
Surface pipe by Alternate: 1 2
Depth to bottom of fresh water 2100
Depth to bottom of usable water 800
Surface pipe planned to be set 200'
Projected Total Depth 3450' feet
Formation Arbuckle

If OWWO: old well info as follows:

Operator
Well Name
Comp Date Old Total Depth

I certify that well will comply with K.S.A. 55-101, et seq., plus eventually plugging hole to KCC specifications.

10/25/85 cementing will be done immediately upon setting production casing.
Date Signature of Operator or Agent Gary Patterson Title Partner

For KCC Use:


Conductor Pipe Required feet; Minimum Surface Pipe Required feet per ft. 1 2
This Authorization Expires 5-25-86 Approved By 11-25-85

Must be filed with the K.C.C. five (5) days prior to commencing well
 This card void if drilling not started within six (6) months of date received by K.C.C.

Important procedures to follow:

1. Notify District office before setting surface casing.
2. Set surface casing by circulating cement to the top.
3. File completion forms ACO-1 with K.C.C. within 90 days of well completion, following instructions on ACO-1, side 1, and including copies of wireline logs.
4. Notify District office 48 hours prior to old well workover or re-entry.
5. Prior to filing Intent, prepare a proposed plugging plan in case well is D & A, then obtain approval of plan when calling district office prior to setting surface pipe.
6. Submit plugging report (CP-4) to K.C.C. after plugging is completed.
7. Obtain an approved injection docket number before disposing of salt water.
8. Notify K.C.C. within 10 days when injection commences or terminates.
9. If an alternate 2 completion, cement in the production pipe from below any usable water to surface within 120 days of spud date.

A Regular Section of Land
1 Mile = 5,280 Ft.

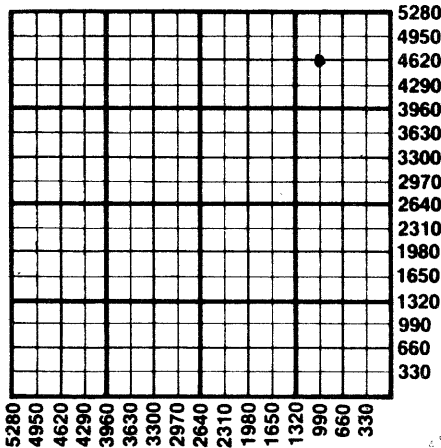

STATE CORPORATION COMMISSION

NOV 25 1985
 11-25-85
 CONSERVATION DIVISION
 Wichita, Kansas

State Corporation Commission of Kansas
 Conservation Division
 200 Colorado Derby Building
 Wichita, Kansas 67202
 (316) 263-3238