

15-065-21734-0000


STATE OF KANSAS
STATE CORPORATION COMMISSION
200 Colorado Derby Bldg.
Wichita, Kansas 67202

Form CP-4
Rev. 12-15-80

WELL PLUGGING RECORD

Give All Information Completely
Make Required Affidavit

COUNTY Graham SEC. 26 TWP. 7S RGE. 23 EXW
Location as in quarters or footage from lines:
NE NW NW

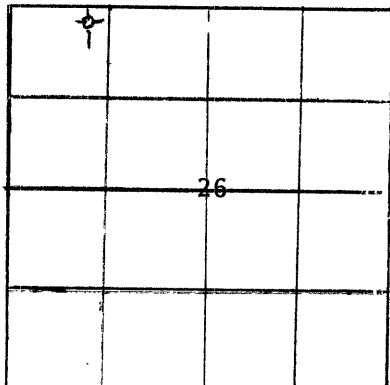

Locate Well
correctly on above
Section Platt.

Lease Owner Gear Petroleum Company, Inc.
Lease Name Jomar Well No. 2-26
Office Address 300 Sutton Place, Wichita, KS 67202
Character of Well (Completed as Oil, Gas or Dry Hole): D&A
Date Well Completed December 21, 1982
Application for plugging filed December 20, 1982
Plugging commenced December 21, 1982
Plugging completed December 21, 1982
Reason for abandonment of well or producing formation

D&A

Was permission obtained from the Conservation Division or it's
Agent's before plugging was commenced? Yes

Name of Conservation Agent who supervised plugging of this well Dennis Hamel

Producing formation _____ Depth to top _____ bottom _____ T.D. 3775'

Show depth and thickness of all water, oil and gas formations.

OIL, GAS OR WATER RECORDS

Casing Record

Formation	Content	From	To	Size	Put in	Pulled Out
				8-5/8"	239'	-0-

Describe in detail the manner in which the well was plugged, indicating where the mud fluid was placed and the method or methods used in introducing it into the hold. If cement or other plugs were used, state the character of same and depth placed, from _____ feet to _____ feet for each plug set.

Hole Plugged:

- @ 1980' w/20 sx
- @ 250' w/100sx
- @ 40' 10 sx
- 10 sx in rathole
- Cmt. w/80 sx 50-50 poz, 5% gel.

RECEIVED
STATE CORPORATION COMMISSION

DEC 29 1982

CONSERVATION DIVISION
Wichita, Kansas

12/29/82


(If additional description is necessary, use BACK of this sheet)

Name of Plugging Contractor Allied Cementing Comapny
Box 31, 332 W. Wichita, Russell, KS 67665

STATE OF Kansas COUNTY OF Sedgwick, ss.

Jim Thatcher, Drilling & Prod. Manager (employee of owner) or (owner or operator) of the above-described well, being first duly sworn on oath, says: That I have knowledge of the facts, statements, and matters herein contained and the log of the above-described well as filed and that the same are true and correct. So help me God.

(Signature) Jim Thatcher
300 Sutton Place, Wichita, KS 67202
(Address)

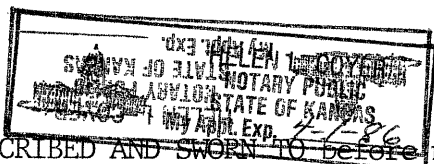

SUBSCRIBED AND SWORN TO before me this 28th day of December, 19 82

Helen L. Coyer
Helen L. Coyer Notary Public.

My Commission expires: April 1, 1986