

STATE OF KANSAS
STATE CORPORATION COMMISSION


WELL PLUGGING RECORD

Give All Information Completely
Make Required Affidavit
Mail or Deliver Report to
Conservation Division
State Corporation Comm.
245 North Water
Wichita, KS 67202

Graham County. Sec. 31 Twp. 7S Rge. 23 E/W
Location as "NE/CNW $\frac{1}{4}$ /SW $\frac{1}{4}$ " or footage from lines
NE SE SE

Lease Owner The Maurice L. Brown Co.
Lease Name CLARK "B" Well No. 1
Office Address 1500 Vickers KSB&T Bldg., Wichita, Ks. 67202
Character of Well (Completed as Oil, Gas or Dry Hole)
Dry Hole

Date Well completed July 26 1976
Application for plugging filed (verbally) July 26 1976
Application for plugging approved (verbally) July 26 1976
Plugging commenced July 26 1976
Plugging completed July 26, 1976
Reason for abandonment of well or producing formation
No commercial quantity of oil or gas encountered.
If a producing well is abandoned, date of last production
19

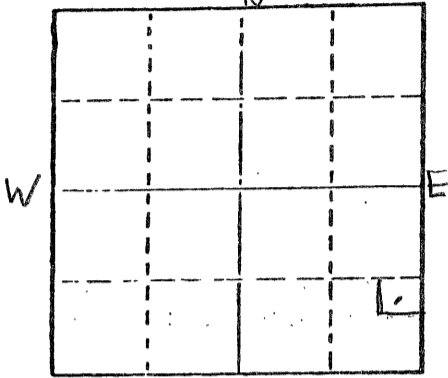

Was permission obtained from the Conservation Division or its agents before plugging was commenced? Yes

Name of Conservation Agent who supervised plugging of this well Leo Massey
Producing formation _____ Depth to top _____ Bottom _____ Total Depth of Well _____
Show depth and thickness of all water, oil and gas formations.

OIL, GAS OR WATER RECORDS

CASING RECORD

FORMATION	CONTENT	FROM	TO	SIZE	PUT IN	PULLED OUT
				8 5/8"	229'K. B.	None

Describe in detail the manner in which the well was plugged, indicating where the mud fluid was placed and the method or methods used in introducing it into the hold. If cement or other plugs were used, state the character of same and depth placed, from _____ feet to _____ feet for each plug set.

- 1st Plug set at 900' with 70 sx.
- 2nd Plug set at 215' with 20 sx.
- 3rd Plug set at 40' with 10 sx.

Plug was down at 4:30 a.m. 7-26-76
State Plugging: Leo Massey

RECEIVED
STATE CORPORATION COMMISSION

AUG 31 1976

CONSERVATION DIVISION
Wichita, Kansas

8/31/76

(If additional description is necessary, use BACK of this sheet)


Name of Plugging Contractor _____

STATE OF Kansas COUNTY OF Sedgwick ss.
Jerry A. Langrehr, Exec. V.P.

(employee of owner) or (owner or operator) of the above-described well, being first duly sworn on oath, says: That I have knowledge of the facts, statements, and matters herein contained and the log of the above-described well as filed and that the same are true and correct. So help me God.

(Signature) Jerry A. Langrehr
801 Union Center, Wichita, Kansas 67202
(Address)

Subscribed and Sworn to before me this 30th day of August, 1976

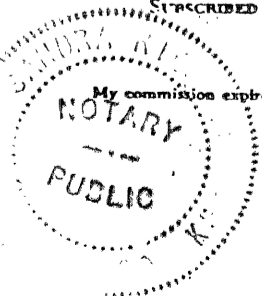

Sandra Richman
Sandra Richman Notary Public

CONTRACTOR'S WELL LOG

15-065-20839-00-00

OPERATOR: The Maurice L. Brown Co.
 CONTRACTOR: Abercrombie Drilling, Inc.
 WELL NAME: CLARK "B" #1
 LOCATION: NE SE SE Sec. 31-7S-23W
 Graham County, Kansas
 SPUD DATE: July 6, 1976
 COMPLETION DATE: July 26, 1976

0	103	Sand & Clay
103	195	Sand & Shale
195	357	Shale
357	1358	Shale & Sand
1358	1480	Shale
1480	1685	Sand
1685	1912	Shale
1912	1947	Anhydrite
1947	3007	Shale
3007	3473	Shale & Lime
3473	3760	Lime
	3760	Rotary Total Depth

RECEIVED
STATE CORPORATION COMMISSION

AUG 31 1976

CONSERVATION DIVISION
Wichita, Kansas

8/31/76

Spud surface hole at 9:00 p.m., July 6, 1976. Cut 231' of 12 1/4" hole, ran 6 jts. 8 5/8" tally 222', set at 229' K.B. with 190 sx. Class "A" cement, 3% Ca. Cl. Cement did circulate. Plug was down at 3:10 a.m. on July 7, 1976.

3760' T.D. Plugged with 70 sx. at 900', 20 sx. at 215', 10 sx. at 40'. Plug was down at 4:30 a.m. 7-26-76. State Plugger - Leo Massey

SAMPLE TOPS:

Anhydrite 1912' (+327)
 B/Anhydrite 1947' (+297)

COPY

STATE OF KANSAS)
) SS
 COUNTY OF SEDGWICK)

Jerry A. Langrehr, Executive Vice President of Abercrombie Drilling, Inc., does hereby state that the above and foregoing is a true and correct copy of the log of the CLARK "B" #1, NE SE SE Section 31-7S-23W, Graham County, Kansas.

ABERCROMBIE DRILLING, INC.

By: Jerry A. Langrehr
 Jerry A. Langrehr, Exec. V.P.

Subscribed and sworn to before me, a Notary Public, in and for the aforesaid county and state as of this 30th day of August, 1976.

Sandra Richman
 Sandra Richman, Notary Public

