


STATE OF KANSAS  
STATE CORPORATION COMMISSION

15-065-60334-00-00

WELL PLUGGING RECORD

Give All Information Completely  
Make Required Affidavit  
Mail or Deliver Report to:  
Conservation Division  
State Corporation Commission  
800 Bitting Building  
Wichita, Kansas

Graham County. Sec. 32 Twp. 7S Rge. 23 (E) W (W)

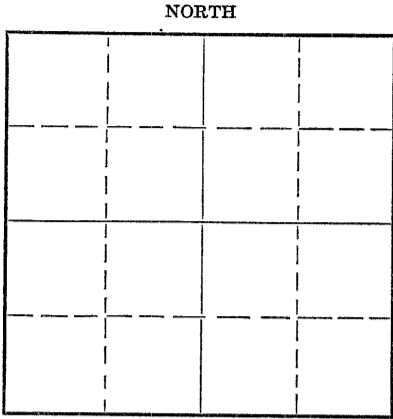

Locate well correctly on above Section Plat

Location as "NE/CNW $\frac{1}{4}$ /SW $\frac{1}{4}$ " or footage from lines NE NE NE  
Lease Owner Anschutz Drilling Company, Inc.  
Lease Name Michaelis Well No. 1  
Office Address 709 Union Nat'l Bk Bldg., Wichita, Kansas  
Character of Well (completed as Oil, Gas or Dry Hole) Dry Hole  
Date well completed 5-27 19 52  
Application for plugging filed 5-27 19 52  
Application for plugging approved 5-27 19 52  
Plugging commenced 5-27 19 52  
Plugging completed 5-27 19 52  
Reason for abandonment of well or producing formation Dry

If a producing well is abandoned, date of last production \_\_\_\_\_ 19 \_\_\_\_  
Was permission obtained from the Conservation Division or its agents before plugging was commenced? Yes

Name of Conservation Agent who supervised plugging of this well Eldon Petty  
Producing formation \_\_\_\_\_ Depth to top \_\_\_\_\_ Bottom \_\_\_\_\_ Total Depth of Well 4180 Feet  
Show depth and thickness of all water, oil and gas formations.

OIL, GAS OR WATER RECORDS

CASING RECORD

Formation	Content	From	To	Size	Put In	Pulled Out
				8-5/8"	161'	

Describe in detail the manner in which the well was plugged, indicating where the mud fluid was placed and the method or methods used in introducing it into the hole. If cement or other plugs were used, state the character of same and depth placed, from \_\_\_\_\_ feet to \_\_\_\_\_ feet for each plug set.

Top plug set at 40' with 10 sacks cement  
Bottom plug set at 100' with 15 sacks cement

(If additional description is necessary, use BACK of this sheet)

Name of Plugging Contractor Anschutz Drilling Company, Inc.  
Address 709 Union Nat'l Bk Bldg., Wichita, Kansas

STATE OF KANSAS, COUNTY OF SEDGWICK, SS. Leon L. Mehler (employee of owner) or (owner or operator) of the above-described well, being first duly sworn on oath, says: That I have knowledge of the facts, statements, and matters herein contained and the log of the above-described well as filed and that the same are true and correct. So help me God.  
(Signature) Leon L. Mehler  
709 Union Nat'l Bk Bldg., Wichita, Ks. (Address)

SUBSCRIBED AND SWORN to before me this 29th day of May 19 52  
My commission expires May 2, 1956  
Notary Public

RECEIVED  
STATE CORPORATION COMMISSION  
JUN 2 - 1952

23-8390-s 6-51-20M

PLUGGING  
FILE SEC 2-T-17R-2  
BOOK PAGE 19 LINE 27

CONSERVATION DIVISION  
Wichita, Kansas  
6/2/52

DRILLER'S LOG

Anschutz Drilling Company, Inc.  
 #1 H. R. Michaelis  
 NE NE NE - 32-7S-23W  
 Graham County, Kansas

<u>FROM</u>	<u>TO</u>	
0	90	Surface clay
90	120	Sand
120	460	Shale
460	1330	Shale & shells
1330	1370	Sand
1370	1550	Shale & shells
1550	1630	Red bed
1630	1740	Sand
1740	2080	Red bed & shale
2080	2110	Anhydrite
2110	2135	Shale & shells
2135	2360	Shale, red bed & shells
2360	2525	Shale & lime
2525	2670	Shale, lime & red bed
2670	2785	Shale, red rock & lime shells
2785	3040	Shale & lime
3040	3100	Shale, lime & red rock
3100	3310	Shale & lime
3310	3390	Lime broken
3390	3530	Shale & lime
3530	3939	Lime
3939	3980	Shale & lime
3980	4020	Lime
4020	4065	Shale & lime
4065	4095	Conglomerate
4095	4125	Chert
4125	4150	Chert & conglomerate
4150	4180	Arbuckle lime
4180		ROTARY TOTAL DEPTH
		D&A

COMMENCED: 5-14-52

COMPLETED: 5-27-52

CASING RECORD:

Set 8-5/8" surface casing at 161 feet with 100 sacks cement and 1 sack calcium chloride.

ELEVATION: 2394KB

TOPS:

- Howard 3310 (-916)
- Topeka 3335 (-941)
- Heebner 3648 (-1254)
- Toronto 3664 (-1275)
- Lansing-Kansas City 3694 (-1300)
- Base-Kansas City 3892 (-1498)
- Marmaton 3912 (-1516)
- Conglomerate 4098 (-1704)
- Arbuckle 4148 (-1754)

STATE OF KANSAS

COUNTY OF SEDGWICK

I hereby that the foregoing is a true and correct copy of the log of Anschutz Drilling Company, Inc., #1 H. R. Michaelis, located NE NE NE of Section 32-7S-23W, Graham County, Kansas.

ANSCHUTZ DRILLING COMPANY, INC.

BY:

*E. B. Snell*  
 E. B. Snell

Subscribed and sworn to before me this 29th day of May, 1952.

*Jacqueline Kinnon*  
 Notary Public

MY COMMISSION EXPIRES: May 2, 1956.

**PLUGGING**  
 FILE SEC-32-T-7-R-220  
 BOOK PAGE-19-27

6/2/52