


15-065-02625-00-00

WELL PLUGGING RECORD

Give All Information Completely
Make Required Affidavit
Mail or Deliver Report to:
Conservation Division
State Corporation Commission
800 Biting Building
Wichita, Kansas

NORTH

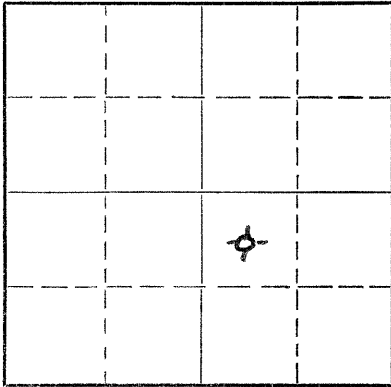

Locate well correctly on above Section Plat

Graham County, Sec. 35 Twp. 7S Rge. (E)23 (W)
Location as "NE/CNW%SW%" or footage from lines C NW 1/4 SE 1/4
Lease Owner Champlin Oil & Refining Co.
Lease Name Stuchlik Well No. 1
Office Address Box 167, Ellinwood, Kansas
Character of Well (completed as Oil, Gas or Dry Hole) Dry hole
Date well completed April 26 1959
Application for plugging filed April 26 1959
Application for plugging approved April 26 (verbal) 1959
Plugging commenced April 26 1959
Plugging completed April 26 1959
Reason for abandonment of well or producing formation _____

If a producing well is abandoned, date of last production _____ 19____
Was permission obtained from the Conservation Division or its agents before plugging was commenced? Yes

Name of Conservation Agent who supervised plugging of this well A. B. Fabricius
Producing formation _____ Depth to top _____ Bottom _____ Total Depth of Well 3790 Feet
Show depth and thickness of all water, oil and gas formations.

OIL, GAS OR WATER RECORDS

CASING RECORD

FORMATION	CONTENT	FROM	TO	SIZE	PUT IN	PULLED OUT
				8-5/8 OD	230'	None

Describe in detail the manner in which the well was plugged, indicating where the mud fluid was placed and the method or methods used in introducing it into the hole. If cement or other plugs were used, state the character of same and depth placed, from _____ feet to _____ feet for each plug set.

Filled hole with heavy rotary mud from total depth to 600' and pumped in 20 sacks of cement then filled hole with heavy mud to 225' and pumped in 20 sacks of cement and filled hole with heavy mud to 40' and pumped in 10 sacks of cement filling hole to bottom of cellar.

RECEIVED
STATE CORPORATION COMMISSION
APR 30 1959
CONSERVATION DIVISION
WICHITA, KANSAS
4/30/59

(If additional description is necessary, use BACK of this sheet)
Name of Plugging Contractor M. B. Armer Drilling Co.
Address 711 Petroleum Building, Wichita, Kansas

STATE OF Kansas, COUNTY OF Barton, ss.
J. W. Meyers (employee of owner) of the above-described well, being first duly sworn on oath, says: That I have knowledge of the facts, statements, and matters herein contained and the log of the above-described well as filed and that the same are true and correct. So help me God.

(Signature) J. W. Meyers
Box 167, Ellinwood, Kansas
(Address)

SUBSCRIBED AND SWORN to before me this 29th day of April, 19 59
M. Kenneth Stearns
Notary Public.

My commission expires 5-22-62

PLUGGING
FILE SEC. 35 T. 7 R. 23W
BOOK PAGE 34 LINE 45

