

CARD MUST BE SIGNED

Starting Date:10.....3.....84.....
month day year 4'30

API Number 15- 121-26,372-00-00

OPERATOR: License # 6251
Name Ballou Oil Well Service
Address Route 5 Box 149
City/State/Zip Paola, KS 66071
Contact Person Pat Ballou
Phone (913) 294-4777

..... NE/4 Sec 31 Twp 17 S, Rge 22 ☒ East
(location) ☐ West

CONTRACTOR: License # 5938
Name C. & M Drilling CO
City/State Paola, KS 66071

...~~4~~725..... Ft North from Southeast Corner of Section
...~~8~~85..... Ft West from Southeast Corner of Section
(Note: Locate well on Section Plat on reverse side)

Nearest lease or unit boundary line 885 feet.

County Miami

Lease Name Wilford Sinclair Well# 7

Domestic well within 330 feet : ☐ yes ☒ no

Municipal well within one mile : ☐ yes ☒ no

Well Drilled For:		Well Class:		Type Equipment:	
☒ Oil	☐ Swd	☒ Infield	☐ Pool Ext.	☒ Mud Rotary	☐ Air Rotary
☐ Gas	☐ Inj	☐ Wildcat		☐ Cable	
☐ OWWO	☐ Expl				

If OWWO: old well info as follows:

Operator

Well Name

Comp Date Old Total Depth

Projected Total Depth 800 feet

Projected Formation at TD

Expected Producing Formations

Depth to Bottom of fresh water 43 feet

Lowest usable water formation

Depth to Bottom of usable water 200 feet

Surface pipe by Alternate : 1 ☐ 2 ☒

Surface pipe to be set 20 **feet**

Conductor pipe if any required feet

Ground surface elevation feet **MSL**

This Authorization Expires 4-2-85

Approved By 10-2-84 

I certify that we will comply with K.S.A. 55-101, et seq., plus eventually plugging hole to K.C.C. specifications.


Date 10/2/84 Signature of Operator or Agent Raquel Robles Title As agent
in HCH/DHE 10/2/84 Form C-1 4/84

Form C-1 4/84

RECEIVED
STATE COMMISSION
10-02-84
OCT 2 1984

CONSERVATION DIVISION
Average K.C.C.

Regular Section of Land
1 Mile = 5,280 Ft.

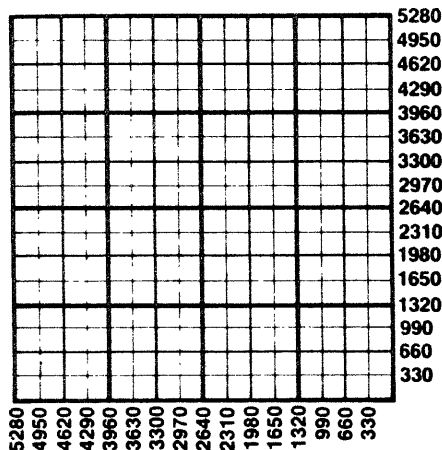

Must be filed with the K.C.C. five (5) days prior to commencing well
This card void if drilling not started within six (6) months of date received by K.C.C.

Important procedures to follow:

1. Notify District office before setting surface casing.
2. Set surface casing by circulating cement to the top.
3. File completion forms ACO-1 with K.C.C. within 90 days of well completion, following instructions on ACO-1, side 1, and including copies of wireline logs.
4. Notify District office 48 hours prior to old well workover or re-entry.
5. Prior to plugging, prepare a plugging plan, then obtain agreement from the appropriate district office for an approved plugging plan.
6. Submit plugging report (CP-4) to K.C.C. after plugging is completed.
7. Obtain an approved injection docket number before disposing of salt water.
8. Notify K.C.C. within 10 days when injection commences or terminates.
9. If an alternate 2 completion, cement in the production pipe from below any usable water to surface within 120 days of spud date.

State Corporation Commission of Kansas
Conservation Division
200 Colorado Derby Building
Wichita, Kansas 67202
(316) 263-3238