

CARD MUST BE TYPED

State of Kansas

CARD MUST BE SIGNED

### NOTICE OF INTENTION TO DRILL

(see rules on reverse side)

OWWO

Expected Spud Date..... December 17, 1987  
month day year

API Number 15— 163-21,457-~~40-01~~

OPERATOR: License # 8061  
Name Oil Producers, Inc. of Kansas  
Address P.O. Box 8647  
City/State/Zip Wichita, Ks. 67208  
Contact Person John S. Weir  
Phone 316 681-0231

NW NW NW Sec. 11 Twp. 8 S, Rg. 18 X East  
4950 ..... Ft. from South Line of Section  
4950 ..... Ft. from East Line of Section

(Note: Locate well on Section Plat on reverse side)

CONTRACTOR: License # 4083  
Name Western Kansas Drilling  
City/State Hays, Ks.

Nearest lease or unit boundary line 330 feet  
County Rooks  
Lease Name Bird Well # 1

Well Drilled For: Well Class: Type Equipment:  
— Oil — Storage XInfield XMud Rotary  
— Gas — Inj — Pool Ext. — Air Rotary  
X OWWO — Expl — Wildcat — Cable

Ground surface elevation ..... feet MSL  
Domestic well within 330 feet: —yes —no  
Municipal well within one mile: —yes —no  
Depth to bottom of fresh water.....  
Depth to bottom of usable water 800

If OWWO: old well info as follows:  
Operator F. & M. Oil Co., Inc.  
Well Name .....  
Comp Date 10/21/81 Old Total Depth 3520

Surface pipe by Alternate: 1 2 X  
Surface pipe planned to be set 208'  
Conductor pipe required .....  
Projected Total Depth 3300 feet  
Formation Lansing

I certify that well will comply with K.S.A. 55-101, et seq., plus eventually plugging hole to KCC specifications.  
Date 12/10/87 Signature of Operator or Agent

John S. Weir Title President

For KCC Use:  
Conductor Pipe Required ..... feet; Minimum Surface Pipe Required ..... feet per Alt.  
This Authorization Expires 6-14-89


Approved By John S. Weir 208  
12-14-87 XO 2

EXPIRES DATE: 12-19-87

Must be filed with the K.C.C. five (5) days prior to commencing well  
 This card void if drilling not started within six (6) months of date received by K.C.C.

**Important procedures to follow:**

**A Regular Section of Land**  
**1 Mile = 5,280 Ft.**

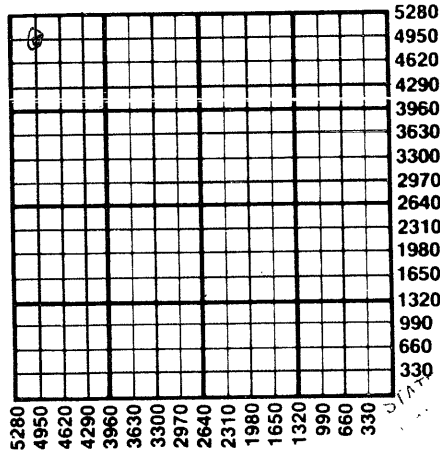

1. Notify District office before setting surface casing.
2. Set surface casing by circulating cement to the top.
3. File completion forms ACO-1 with K.C.C. within 120 days of well spud date, following instructions on ACO-1, side 1, and including copies of wireline logs.
4. Notify District office 48 hours prior to old well workover or re-entry.
5. Prior to filing Intent, prepare a proposed plugging plan in case well is D & A, then obtain approval of plan when calling district office prior to setting surface pipe.
6. Submit plugging report (CP-4) to K.C.C. after plugging is completed.
7. Obtain an approved injection docket number before disposing of salt water.
8. Notify K.C.C. within 10 days when injection commences or terminates.
9. If an alternate 2 completion, cement in the production pipe from below any usable water to surface within 120 days of spud date.

DEC 4 1987  
 12-14-1987

State Corporation Commission of Kansas  
 Conservation Division  
 200 Colorado Derby Building  
 Wichita, Kansas 67202-1212  
 (316) 263-3238