

CARD MUST BE TYPED

State of Kansas
NOTICE OF INTENTION TO DRILL
(see rules on reverse side)

CARD MUST BE SIGNED

Starting Date: 7 13 85
month day year

API Number 15- 059-23978 00-00

OPERATOR: License # 6142
Name Town Oil Co.
Address Rt. 4
City/State/Zip Paola, KS 66071
Contact Person Lester Town
Phone 913-294-2125

SE (location) Sec 13 Twp 16 S, Rge 20
 East
 West
825 Ft North from Southeast Corner of Section ⁶²⁵
1815 Ft West from Southeast Corner of Section
(Note: Locate well on Section Plat on reverse side)

CONTRACTOR: License # 6142
Name COMPANY TOOLS
City/State

Nearest lease or unit boundary line 825 feet.
County Franklin
Lease Name Van Horn Well# 7

Well Drilled For: Well Class: Type Equipment:
 Oil Swd Infield Mud Rotary
 Gas Inj Pool Ext. Air Rotary
 OWWO Expl Wildcat Cable

Domestic well within 330 feet: yes no
Municipal well within one mile: yes no

If OWWO: old well info as follows:
Operator

Well Name

Comp Date Old Total Depth

Projected Total Depth 800 feet

Projected Formation at TD Bartlesville

Expected Producing Formations Bartlesville

Depth to Bottom of fresh water 0 1275 feet
Lowest usable water formation ---
Depth to Bottom of usable water 200 200 feet
Surface pipe by Alternate: 1 2 20
Surface pipe to be set feet
Conductor pipe if any required 0 feet
Ground surface elevation feet MSL
This Authorization Expires 1-8-86
Approved By 7-8-85 *RC*

I certify that we will comply with K.S.A. 55-101, et seq., plus eventually plugging hole to K.C.C. specifications.

RC
RCM for KOHE

Date 7-2-85 Signature of Operator or Agent Lester Town Title Partner


Must be filed with the K.C.C. five (5) days prior to commencing well
 This card void if drilling not started within six (6) months of date received by K.C.C.

7-8-85
 RECEIVED
 STATE CORPORATION COMMISSION
 NOV 08 1985
 CONSERVATION DIVISION
 Wichita, Kansas

Important procedures to follow

1. Notify District office before setting surface casing.
2. Set surface casing by circulating cement to the top.
3. File completion forms ACO-1 with K.C.C. within 90 days of well completion, following instructions on ACO-1, side 1, and including copies of wireline logs.
4. Notify District office 48 hours prior to old well workover or re-entry.
5. Prior to plugging, prepare a plugging plan, then obtain agreement from the appropriate district office for an approved plugging plan.
6. Submit plugging report (CP-4) to K.C.C. after plugging is completed.
7. Obtain an approved injection docket number before disposing of salt water.
8. Notify K.C.C. within 10 days when injection commences or terminates.
9. If an alternate 2 completion, cement in the production pipe from below any usable water to surface within 120 days of spud date.

**A Regular Section of Land
 1 Mile = 5,280 Ft.**

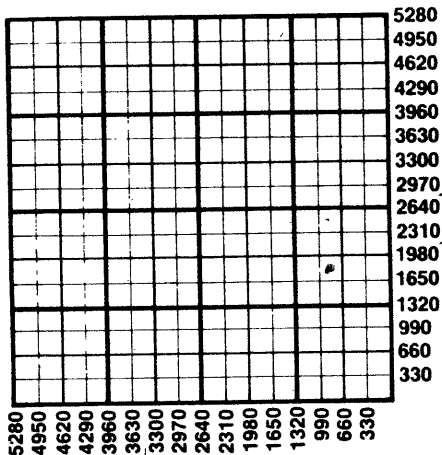

State Corporation Commission of Kansas
 Conservation Division
 200 Colorado Derby Building
 Wichita, Kansas 67202
 (316) 263-3238