

CARD MUST BE TYPED

State of Kansas

CARD MUST BE SIGNED

NOTICE OF INTENTION TO DRILL

(see rules on reverse side)

Expected Spud Date..... 4 / 28 / 88
month day year

API Number 15— 059-24,331-00-20 *JE*

OPERATOR: License # 8509
Name EVANS ENERGY DEVELOPMENT INC.
Address 401 S. Main, Suite 11
City/State/Zip Ottawa, KS 66067
Contact Person Scott Evans
Phone (913)-242-5733

SE SW SW Sec. 13 Twp. 16 S, Rg. 20 X East
330 Ft. from South Line of Section
4290 Ft. from East Line of Section

(Note: Locate well on Section Plat on reverse side)

CONTRACTOR: License # Company Tools
Name

Nearest lease or unit boundary line 330 feet
County Franklin
Lease Name Harshberger Well # 1

Well Drilled For: Well Class: Type Equipment:
X Oil — Storage — Infield — Mud Rotary
— Gas — Inj — Pool Ext. X Air Rotary
— OWWO — Expl X Wildcat — Cable

Ground surface elevation feet MSL
Domestic well within 330 feet: —yes Xno
Municipal well within one mile: —yes Xno

If OWWO: old well info as follows:
Operator

Depth to bottom of fresh water.....
Depth to bottom of usable water 200
Surface pipe by Alternate: 1 2 X

I certify that well will comply with K.S.A. 55-101, et seq., plus eventually plugging hole to KCC specifications
Date

Surface pipe planned to be set 20'
Conductor pipe required

For KCC Use:
Conductor Pipe Required feet; Minimum Surface Pipe Required

Projected Total Depth 900 feet
Formation Bartlesville

This Authorization Expires 10-22-88

Approved By RCH 4-22-88 20 feet per Alt. X(2)


EFFECTIVE DATE: 4-27-88

Must be filed with the K.C.C. five (5) days prior to commencing well
 This card void if drilling not started within six (6) months of date received by K.C.C.

Important procedures to follow:

1. Notify District office before setting surface casing.
 2. Set surface casing by circulating cement to the top.
 3. File completion forms ACO-1 with K.C.C. within 120 days of well spud date, following instructions on ACO-1, side 1, and including copies of wireline logs.
 4. Notify District office 48 hours prior to old well workover or re-entry.
 5. Prior to filing Intent, prepare a proposed plugging plan in case well is D & A, then obtain approval of plan when calling district office prior to setting surface pipe.
 6. Submit plugging report (CP-4) to K.C.C. after plugging is completed.
 7. Obtain an approved injection docket number before disposing of salt water.
- Notify K.C.C. within 10 days when injection commences or terminates.

A Regular Section of Land
1 Mile = 5,280 Ft.

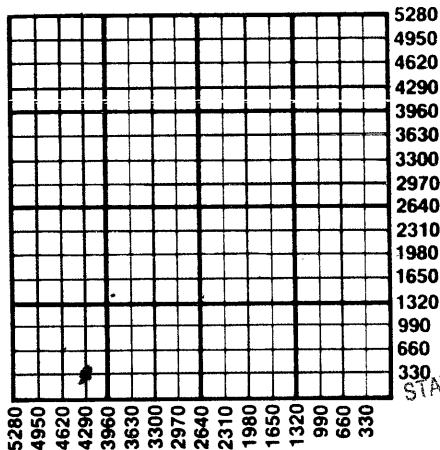

4-22-88
 APR 22 1988
 RECEIVED
 STATE CORPORATION COMMISSION
 CONSERVATION DIVISION
 Wichita, Kansas

Notify alternate 2 completion, cement in the production pipe from below any usable water to surface within 120 days of spud date.

State Corporation Commission of Kansas
 Conservation Division
 200 Colorado Derby Building
 Wichita, Kansas 67202-1212
 (316) 263-3238