

CARD MUST BE TYPED

State of Kansas

CARD MUST BE SIGNED

NOTICE OF INTENTION TO DRILL

(see rules on reverse side)

Starting Date 8 month 18 day 85 year

API Number 15— 121-26,632-00-00

OPERATOR: License # 6142

NW NW Sec. 24 Twp. 17 S, Rg. 22 X East

Name Town Oil Co.

4830 Ft. from South Line of Section

Address Rt. 4

4500 Ft. from East Line of Section

City/State/Zip Paola, KS. 66071

(Note: Locate well on Section Plat on reverse side)

Contact Person Lester Town

Phone 913 294-2125

CONTRACTOR: License # COMPANY TOOLS

Name

City/State

Well Drilled For: Well Class: Type Equipment:

X Oil SWD X Infield X Mud Rotary

Gas Inj Pool Ext. Air Rotary

OWWO Expl Wildcat Cable

If OWWO: old well info as follows:

Operator

Well Name

Comp Date Old Total Depth.....

I certify that well will comply with K.S.A. 55-101, et seq., plus eventually plugging hole to KCC specifications.

Date 8-8-85 Signature of Operator or Agent Norma Rumbaut Title Agent

For KCC Use:

Conductor Pipe Required feet; Minimum Surface Pipe Required feet per Alt. 1 2

This Authorization Expires 2-13-86 Approved By 8-13-85 R

Nearest lease or unit boundary line 450 feet

County Miami

Lease Name Doherty Well # CW 1

Ground surface elevation feet MSL

Domestic well within 330 feet: yes X no

Municipal well within one mile: yes X no

Surface pipe by Alternate: 1 2 X

Depth to bottom of fresh water 240-0

Depth to bottom of usable water 300 200

Surface pipe planned to be set 20

Projected Total Depth 800 feet

Formation Bartlesville


pet for KONE

Must be filed with the K.C.C. five (5) days prior to commencing well
This card void if drilling not started within six (6) months of date received by K.C.C.

Important procedures to follow:

1. Notify District office before setting surface casing.
2. Set surface casing by circulating cement to the top.
3. File completion forms ACO-1 with K.C.C. within 90 days of well completion, following instructions on ACO-1, side 1, and including copies of wireline logs.
4. Notify District office 48 hours prior to old well workover or re-entry.
5. Prior to filing Intent, prepare a proposed plugging plan in case well is D & A, then obtain approval of plan when calling district office prior to setting surface pipe.
6. Submit plugging report (CP-4) to K.C.C. after plugging is completed.
7. Obtain an approved injection docket number before disposing of salt water.
8. Notify K.C.C. within 10 days when injection commences or terminates.
9. If an alternate 2 completion, cement in the production pipe from below any usable water to surface within 120 days of spud date.

A Regular Section of Land 1 Mile = 5,280 Ft.

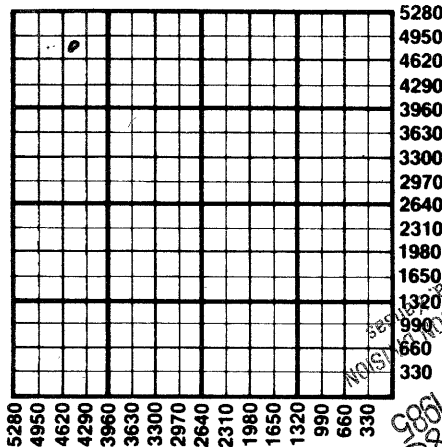

RECEIVED
AUG 13 1985
STATE CORPORATION COMMISSION
WICHITA, KANSAS

State Corporation Commission of Kansas
Conservation Division
200 Colorado Derby Building
Wichita, Kansas 67202
(316) 263-3238