

CARD MUST BE TYPED

State of Kansas

CARD MUST BE SIGNED

NOTICE OF INTENTION TO DRILL

(see rules on reverse side)

Expected Spud Date..... 10/23/88
month day year

API Number 15-059-24,391-00-00 ✓ DA
XX

OPERATOR: License #..... 8509
Name..... EVAN'S ENERGY DEVELOPMENT
Address..... 310 N. HOSPITAL DRIVE
City/State/Zip..... PAOLA 66071
Contact Person..... SCOTT EVANS
Phone..... (913) 294-9083

NW SE SW 16 16 20 — East
990 Twp..... S, Rg..... — West
3630 Ft. from South Line of Section
..... Ft. from East Line of Section

(Note: Locate well on Section Plat on reverse side) 990

CONTRACTOR: License #.....
Name..... CO TOOLS
City/State.....

Nearest lease or unit boundary line..... FRANKLIN..... feet
County..... BARNES..... 2

Well Drilled For: Well Class: Type Equipment:
 Oil — Storage — Infield Mud Rotary
 Gas — Inj — Pool Ext. — Air Rotary
— OWWO — Expl Wildcat — Cable

Lease Name..... 990 Well #.....
Ground surface elevation..... feet MSL
Domestic well within 330 feet: — yes no

If OWWO: old well info as follows:
Operator.....
Well Name.....
Comp Date..... Old Total Depth.....

Municipal well within one mile: 50 — yes — no
Depth to bottom of fresh water.....
Depth to bottom of usable water..... 150 200

I certify that well will comply with K.S.A. 55-101, et seq., plus eventually plugging hole to KCC specifications.
Date 10/14/88 Signature of Operator or Agent *[Signature]* Title AS AGENT

Surface pipe by Alternate: 2d — 2 —
Surface pipe planned to be set..... *****

For KCC Use:
Conductor Pipe Required..... feet; Minimum Surface Pipe Required..... 20' feet per Alt. 2
This Authorization Expires 9-14-89 Approved By LKM 10-14-88


EFFECTIVE DATE: 10-19-88

Must be filed with the K.C.C. five (5) days prior to commencing well
This card void if drilling not started within six (6) months of date received by K.C.C.

Important procedures to follow:

1. Notify District office before setting surface casing.
2. Set surface casing by circulating cement to the top.
3. File completion forms ACO-1 with K.C.C. within 120 days of well spud date, following instructions on ACO-1, side 1, and including copies of wireline logs.
4. Notify District office 48 hours prior to old well workover or re-entry.
5. Prior to filing Intent, prepare a proposed plugging plan in case well is D & A, then obtain approval of plan when calling district office prior to setting surface pipe.
6. Submit plugging report (CP-4) to K.C.C. after plugging is completed.
7. Obtain an approved injection docket number before disposing of salt water.
8. Notify K.C.C. within 10 days when injection commences or terminates.
9. If an alternate 2 completion, cement in the production pipe from below any usable water to surface within 120 days of spud date.

A Regular Section of Land
1 Mile = 5,280 Ft.

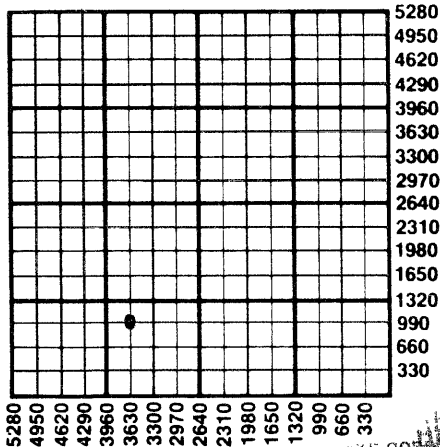

RECEIVED
STATE CORPORATION COMMISSION

10-14-88
OCT 14 1988
CONSERVATION DIVISION
Wichita, Kansas

State Corporation Commission of Kansas
Conservation Division
200 Colorado Derby Building
Wichita, Kansas 67202-1212
(316) 263-3238