

CARD MUST BE TYPED

State of Kansas

CARD MUST BE SIGNED

NOTICE OF INTENTION TO DRILL

(see rules on reverse side)

Expected Spud Date. OCTOBER 31, 1987 month day year

API Number 15- 059-24,287-00-000 X East

OPERATOR: License # #9873

5/2 SE SE NE 19 16 20 Sec. Twp. S, Rg. West

Name PAINTER OIL COMPANY

2805 Ft. from South Line of Section

Address BOX 141 B, ROUTE 2

330 Ft. from East Line of Section

City/State/Zip WELLSVILLE, KANSAS 66092

(Note: Locate well on Section Plat on reverse side)

Contact Person JOE SMITH

Nearest lease or unit boundary line 330 feet

Phone (913) 242-7310

County FRANKLIN

CONTRACTOR: License # 3417

Lease Name JOHN MUSACK Well # #2

Name SIMPSON DRILLING

Ground surface elevation feet MSL

City/State ROUTE 2, BOX 133, OSAWATOMIE, KS 66064

Domestic well within 330 feet: yes X no

Well Drilled For: Well Class: Type Equipment:

Municipal well within one mile: yes X no

X Oil Storage X Infield X Mud Rotary

Depth to bottom of fresh water

Gas Inj Pool Ext Air Rotary

Depth to bottom of usable water 200

OWWO Expl Wildcat Cable

Surface pipe by Alternate: 1 X

If OWWO: old well info as follows:

Surface pipe planned to be set 20

Operator

Conductor pipe required

Well Name

Projected Total Depth 900 feet

Comp Date Old Total Depth

Formation BARTLESVILLE

I certify that well will comply with K.S.A. 55-101, et seq., plus eventually plugging hole to KCC specifications.

Date 10/29/87. Signature of Operator or Agent [Signature] Title AS AGENT

For KCC Use:

Conductor Pipe Required feet; Minimum Surface Pipe Required feet per Alt. X(2)

This Authorization Expires 4-30-88 Approved By [Signature] Per 10-30-87


EFFECTIVE DATE: 11-3-87

Must be filed with the K.C.C. five (5) days prior to commencing well
This card void if drilling not started within six (6) months of date received by K.C.C.

Important procedures to follow:

1. Notify District office before setting surface casing.
2. Set surface casing by circulating cement to the top.
3. File completion forms ACO-1 with K.C.C. within 120 days of well spud date, following instructions on ACO-1, side 1, and including copies of wireline logs.
4. Notify District office 48 hours prior to old well workover or re-entry.
5. Prior to filing Intent, prepare a proposed plugging plan in case well is D & A, then obtain approval of plan when calling district office prior to setting surface pipe.
6. Submit plugging report (CP-4) to K.C.C. after plugging is completed.
7. Obtain an approved injection docket number before disposing of salt water.
8. Notify K.C.C. within 10 days when injection commences or terminates.
9. If an alternate 2 completion, cement in the production pipe from below any usable water to surface within 120 days of spud date.

A Regular Section of Land
1 Mile = 5,280 Ft.

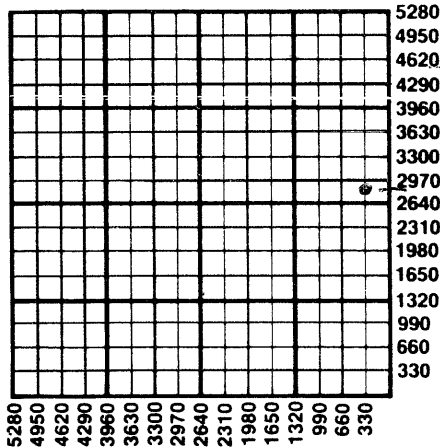

10-30-87

State Corporation Commission of Kansas
Conservation Division
200 Colorado Derby Building
Wichita, Kansas 67202-1212
(316) 263-3238