

CARD MUST BE TYPED

State of Kansas

CARD MUST BE SIGNED

### NOTICE OF INTENTION TO DRILL

(see rules on reverse side)

Expected Spud Date..... 11/12/87  
month day year

API Number 15— 059-24289-00-00

OPERATOR: License #..... 9873

SE SE NE Sec. 19 Twp. 16 S, Rg. 20 XX East

Name..... PAINTER OIL COMPANY

Address..... P.O. BOX 141B, RT. 2

City/State/Zip..... WELLSVILLE 66092

Contact Person..... JOE SMITH

Phone..... (913) 242-7310

2970 Ft. from South Line of Section

330 Ft. from East Line of Section

(Note: Locate well on Section Plat on reverse side)

Nearest lease or unit boundary line..... 330 feet

County..... FRANKLIN

Lease Name..... JOHN MUSACK Well #..... 4

Ground surface elevation..... feet MSL

Domestic well within 330 feet:..... yes XX no

Municipal well within one mile:..... yes XX no

Depth to bottom of fresh water.....

Depth to bottom of usable water..... 200

Surface pipe by Alternate:..... 1 2 XX

Surface pipe planned to be set..... 20

Conductor pipe required.....

Projected Total Depth..... 900 feet

Formation..... BARTLESVILLE

Well Drilled For: Well Class: Type Equipment:

XX Oil Storage XX Infield XX Mud Rotary

Gas Inj Pool Ext Air Rotary

OWWO Expl Wildcat Cable

If OWWO: old well info as follows:

Operator.....

Well Name.....

Comp Date..... Old Total Depth.....

I certify that well will comply with K.S.A. 55-101, et seq., plus eventually plugging hole to KCC specifications.

Date ..11/11/87... Signature of Operator or Agent Joe Smith Title AS AGENT

For KCC Use:

Conductor Pipe Required..... feet; Minimum Surface Pipe Required..... 20 feet per Alt. X(2)

This Authorization Expires..... 5-12-88 Approved By Joe Smith 11-12-87


EFFECTIVE DATE: 5-17-87

Must be filed with the K.C.C. five (5) days prior to commencing well  
This card void if drilling not started within six (6) months of date received by K.C.C.

**Important procedures to follow:**

1. Notify District office before setting surface casing.
2. Set surface casing by circulating cement to the top.
3. File completion forms ACO-1 with K.C.C. within 120 days of well spud date, following instructions on ACO-1, side 1, and including copies of wireline logs.
4. Notify District office 48 hours prior to old well workover or re-entry.
5. Prior to filing Intent, prepare a proposed plugging plan in case well is D & A, then obtain approval of plan when calling district office prior to setting surface pipe.
6. Submit plugging report (CP-4) to K.C.C. after plugging is completed.
7. Obtain an approved injection docket number before disposing of salt water.
8. Notify K.C.C. within 10 days when injection commences or terminates.
9. If an alternate 2 completion, cement in the production pipe from below any usable water to surface within 120 days of spud date.

**A Regular Section of Land**  
**1 Mile = 5,280 Ft.**

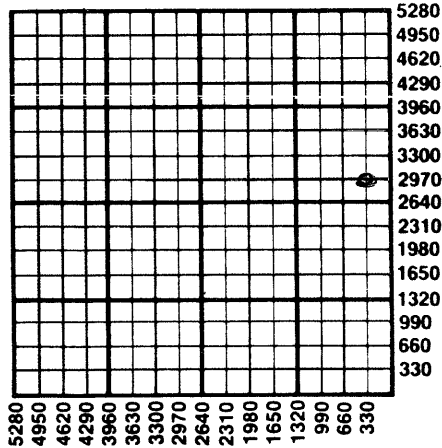

State Corporation Commission of Kansas  
Conservation Division  
200 Colorado Derby Building  
Wichita, Kansas 67202-1212  
(316) 263-3238