

CARD MUST BE TYPED

State of Kansas

CARD MUST BE SIGNED

# NOTICE OF INTENTION TO DRILL

(see rules on reverse side)

Expected Spud Date. JULY 10, 1987  
month day year

API Number 15— 059-24,249-00-00  
 East

OPERATOR: License # #9233  
Name MIDLAND ENTERPRISES, INC.  
Address 935 SUNSET  
City/State/Zip LAWRENCE, KANSAS 66044  
Contact Person JONATHAN GARRETT  
Phone (913) 841-6219

App. SW SE NE Sec. 21 Twp. 15 S, Rg. 21  
2970 Ft. from South Line of Section  
1000 Ft. from East Line of Section

(Note: Locate well on Section Plat on reverse side)

CONTRACTOR: License # 3417  
Name SIMPSON DRILLING  
City/State 901 GARFIELD TOPEKA, KS 66066

Nearest lease or unit boundary line 170 feet  
County FRANKLIN  
Lease Name LARRICK Well # 1

Well Drilled For: Well Class: Type Equipment:  
 Oil  Storage  Infield  Mud Rotary  
 Gas  Inj  Pool Ext.  Air Rotary  
 OWWO  Expl  Wildcat  Cable

Ground surface elevation ..... feet MSL  
Domestic well within 330 feet:  yes  no  
Municipal well within one mile:  yes  no

If OWWO: old well info as follows:

Depth to bottom of fresh water. 200-260  
Depth to bottom of usable water 250-200  
Surface pipe by Alternate:  1  2

Operator .....  
Well Name .....  
Comp Date ..... Old Total Depth.....

Surface pipe planned to be set 40  
Conductor pipe required .....  
Projected Total Depth 1000 feet

I certify that well will comply with K.S.A. 55-101, et seq., plus eventually plugging hole to KCC specifications.

Date 7-10-87 Signature of Operator or Agent Jonathan Garrett Title AS AGENT

For KCC Use:

Conductor Pipe Required ..... feet; Minimum Surface Pipe Required 20 feet per Alt.  2


This Authorization Expires 1-10-88 Approved By FAH 7-10-87

Must be filed with the K.C.C. five (5) days prior to commencing well  
 This card void if drilling not started within six (6) months of date received by K.C.C.

**Important procedures to follow:**

1. Notify District office before setting surface casing.
2. Set surface casing by circulating cement to the top.
3. File completion forms ACO-1 with K.C.C. within 120 days of well spud date, following instructions on ACO-1, side 1, and including copies of wireline logs.
4. Notify District office 48 hours prior to old well workover or re-entry.
5. Prior to filing Intent, prepare a proposed plugging plan in case well is D & A, then obtain approval of plan when calling district office prior to setting surface pipe.
6. Submit plugging report (CP-4) to K.C.C. after plugging is completed.
7. Obtain an approved injection docket number before disposing of salt water.
8. Notify K.C.C. within 10 days when injection commences or terminates.

**A Regular Section of Land**  
 1 Mile = 5,280 Ft.

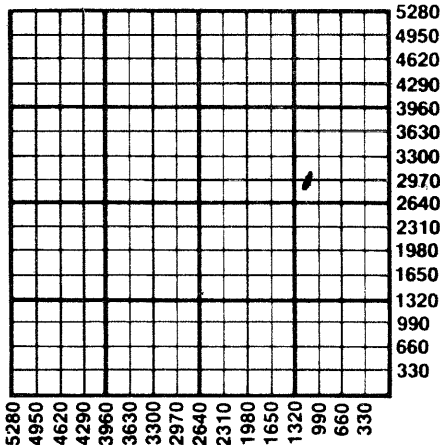

RECEIVED  
 STATE CORPORATION COMMISSION

9. If an alternate 2 completion, cement in the production pipe from below any usable water to surface within 120 days of spud date.

JUL 10 1987  
 7-10-87  
 CONSERVATION DIVISION  
 Wichita, Kansas

State Corporation Commission of Kansas  
 Conservation Division  
 200 Colorado Derby Building  
 Wichita, Kansas 67202-1212  
 (316) 263-3238