

CARD MUST BE TYPED

State of Kansas

CARD MUST BE SIGNED

NOTICE OF INTENTION TO DRILL

(see rules on reverse side)

Starting Date September 24, 1985
month day year 3:00

API Number 15- 059-24,066-00-00
XX East

OPERATOR: License # 7847 app.

SE SE SE Sec. 27. Twp. 15. S, Rg. 21. West

Name ... Wiseman Productions

..... 450 Ft. from South Line of Section

Address R. R. 1

..... 10 Ft. from East Line of Section

City/State/Zip ... Wellsville, KS. 66092

(Note: Locate well on Section Plat on reverse side)

Contact Person ... Max Wiseman

Phone 913.883.2714

Nearest lease or unit boundary line 450 feet

CONTRACTOR: License # 5820

County ... Franklin

Name Kent. DEB, C.

Lease Name ... Max Wiseman Well # ... 5

City/State 332 W. 8th, Garnett, KS. 66032

Ground surface elevation na feet MSL

Well Drilled For: Well Class: Type Equipment:

Domestic well within 330 feet: ... yes no

Oil SWD Infield Mud Rotary

Municipal well within one mile: ... yes no

Gas Inj Pool Ext. Air Rotary

Surface pipe by Alternate: 1 2

OWWO Expl Wildcat Cable

Depth to bottom of fresh water 55

If OWWO: old well info as follows:

Depth to bottom of usable water 200

Operator

Surface pipe planned to be set 20

Well Name

Projected Total Depth 750 feet

Comp Date Old Total Depth.....

Formation Squirrel

I certify that well will comply with K.S.A. 55-101, et seq., plus eventually plugging hole to KCC specifications.

fact/KCC

..... cementing will be done immediately upon setting production casing.

Date .. 9/24/85 Signature of Operator or Agent *Chas. Durbium* Title as agent

For KCC Use:

Conductor Pipe Required feet; Minimum Surface Pipe Required feet per Alt. 2

This Authorization Expires 3-24-86 Approved By 9-24-85


RECEIVED
STATE CORPORATION COMMISSION
KANSAS

Must be filed with the K.C.C. five (5) days prior to commencing well card void if drilling not started within six (6) months of date received by K.C.C.

SEP 24 1985

9-24-85

CONSERVATION DIVISION
Wichita, Kansas
Ac Regular Section of Land
1 Mile = 5,280 Ft.

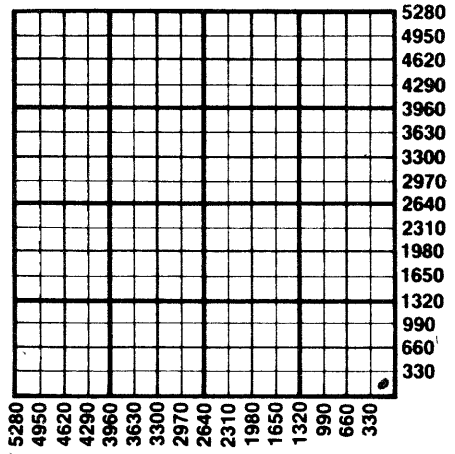

Important procedures to follow:

1. Notify District office before setting surface casing.
2. Set surface casing by circulating cement to the top.
3. File completion forms ACO-1 with K.C.C. within 90 days of well completion, following instructions on ACO-1, side 1, and including copies of wireline logs.
4. Notify District office 48 hours prior to old well workover or re-entry.
5. Prior to filing Intent, prepare a proposed plugging plan in case well is D & A, then obtain approval of plan when calling district office prior to setting surface pipe.
6. Submit plugging report (CP-4) to K.C.C. after plugging is completed.
7. Obtain an approved injection docket number before disposing of salt water.
8. Notify K.C.C. within 10 days when injection commences or terminates.
9. If an alternate 2 completion, cement in the production pipe from below any usable water to surface within 120 days of spud date.

State Corporation Commission of Kansas
Conservation Division
200 Colorado Derby Building
Wichita, Kansas 67202
(316) 263-3238