

P CARD MUST BE TYPED

State of Kansas

CARD MUST BE SIGNED

### NOTICE OF INTENTION TO DRILL

(see rules on reverse side)

Expected Spud Date..... August 4, 1987.....  
month day year

API Number 15— 059-24255-00-00

OPERATOR: License # 9873

NW NW NE Sec. 15 Twp. 16 S, Rg. 20  East  
 West

Name ... Painter Oil Company

Address Box 141 B, Route 2

City/State/Zip Wellsville, KS 66092

Contact Person Joe Smith

Phone (913) 242-7310

4950 2499 Ft. from South Line of Section  
Ft. from East Line of Section

(Note: Locate well on Section Plat on reverse side)

Nearest lease or unit boundary line 330 feet

County Franklin

Lease Name Harry Woods Well # 1

Ground surface elevation feet MSL

Domestic well within 330 feet:  yes  no

Municipal well within one mile:  yes  no

Depth to bottom of fresh water 60

Depth to bottom of usable water 200

Surface pipe by Alternate: 1  2

Surface pipe planned to be set 40

Conductor pipe required

Projected Total Depth 1150 feet

Formation Bartlesville

CONTRACTOR: License # 3417

Name Simpson Drilling

City/State Box 133, Osawatomie, KS 66064

Well Drilled For: Well Class: Type Equipment:

Oil  Storage  Infield  Mud Rotary

Gas  Inj  Pool Ext.  Air Rotary

OWWO  Expl  Wildcat  Cable

If OWWO: old well info as follows:

Operator

Well Name

Comp Date Old Total Depth

I certify that well will comply with K.S.A. 55-101, et seq., plus eventually plugging hole to KCC specifications.

Date 8/4/87 Signature of Operator or Agent Greg Engler Title

For KCC Use:

Conductor Pipe Required feet; Minimum Surface Pipe Required 20 feet per Alt. 1 (2)


This Authorization Expires 2-3-88 Approved By DQ 8-3-87

Must be filed with the K.C.C. five (5) days prior to commencing well  
 This card void if drilling not started within six (6) months of date received by K.C.C.

**Important procedures to follow:**

1. Notify District office before setting surface casing.
2. Set surface casing by circulating cement to the top.
3. File completion forms ACO-1 with K.C.C. within 120 days of well spud date, following instructions on ACO-1, side 1, and including copies of wireline logs.
4. Notify District office 48 hours prior to old well workover or re-entry.
5. Prior to filing Intent, prepare a proposed plugging plan in case well is D & A, then obtain approval of plan when calling district office prior to setting surface pipe.
6. Submit plugging report (CP-4) to K.C.C. after plugging is completed.
7. Obtain an approved injection docket number before disposing of salt water.
8. Notify K.C.C. within 10 days when injection commences or terminates.
9. If an alternate 2 completion, cement in the production pipe from below any usable water to surface within 120 days of spud date.

**A Regular Section of Land**  
**1 Mile = 5,280 Ft.**

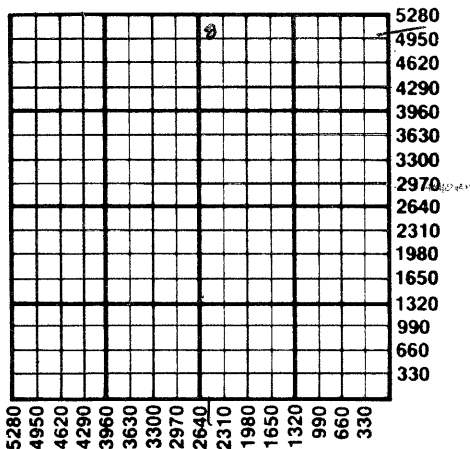

83-87

RECEIVED  
 STATE CORPORATION COMMISSION  
 AUG 3 1987  
 CONSERVATION DIVISION

Wichita, Kansas  
 State Corporation Commission  
 Conservation Division  
 200 Colorado Derby Building  
 Wichita, Kansas 67202-1212  
 (316) 263-3238