

CARD MUST BE TYPED

State of Kansas

CARD MUST BE SIGNED

NOTICE OF INTENTION TO DRILL

(see rules on reverse side)

Expected Spud Date..... 01/25/88
month day year

API Number 15- 059-24301-00-00 ¹⁵¹⁶

OPERATOR: License # 6807

Sec. 16 Twp. 16 S, Rg. 20 ^{XX} East

Name OIL DRILLERS & DEVELOPERS

1020 Ft. from South Line of Section

Address 901 Garfield

4980 Ft. from East Line of Section

City/State/Zip TOPEKA 66606

Contact Person Jack Simpson

Phone (913) 755-3344

(Note: Locate well on Section Plat on reverse side)
Nearest lease or unit boundary line 300 feet
County Franklin

CONTRACTOR: License # 3417

Lease Name R. Fritts Well # 1

Name Simpson Drilling

City/State Wellsville, Kansas 66092

Ground surface elevation feet MSL

Well Drilled For: Well Class: Type Equipment:

Domestic well within 330 feet: yes no

Oil Storage Infield Mud Rotary

Municipal well within one mile: yes no

Gas Inj Pool Ext. Air Rotary

Depth to bottom of fresh water.....

OWWO Expil Wildcat Cable

Depth to bottom of usable water.....

If OWWO: old well info as follows:

Surface pipe by Alternate: 1 2

Operator.....

Surface pipe planned to be set 20

Well Name.....

Conductor pipe required.....

Comp Date..... Old Total Depth.....

Projected Total Depth 900 feet

Formation Bartlesville

I certify that well will comply with K.S.A. 55-101, et seq., plus eventually plugging hole to KCC specifications.

Date Signature of Operator or Agent Greg Engeman Title As Agent

For KCC Use:

Conductor Pipe Required..... feet; Minimum Surface Pipe Required..... feet per Alt. ②

This Authorization Expires 7-22-88 Approved By Dec 1-22-88


EFFECTIVE DATE: 1-27-88

Must be filed with the K.C.C. five (5) days prior to commencing well
 This card void if drilling not started within six (6) months of date received by K.C.C.

Important procedures to follow:

1. Notify District office before setting surface casing.
2. Set surface casing by circulating cement to the top.
3. File completion forms ACO-1 with K.C.C. within 120 days of well spud date, following instructions on ACO-1, side 1, and including copies of wireline logs.
4. Notify District office 48 hours prior to old well workover or re-entry.
5. Prior to filing Intent, prepare a proposed plugging plan in case well is D & A, then obtain approval of plan when calling district office prior to setting surface pipe.
6. Submit plugging report (CP-4) to K.C.C. after plugging is completed.
7. Obtain an approved injection docket number before disposing of salt water.
8. Notify K.C.C. within 10 days when injection commences or terminates.
9. If an alternate 2 completion, cement in the production pipe from below any usable water to surface within 120 days of spud date.

A Regular Section of Land
1 Mile = 5,280 Ft.

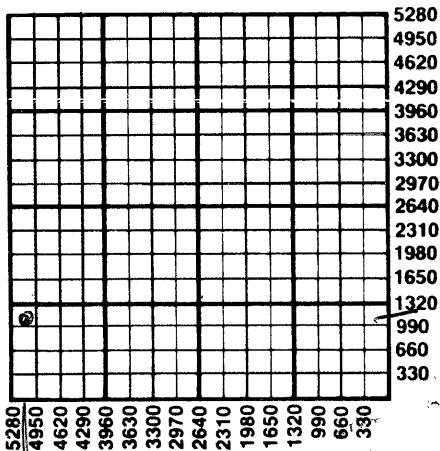

JAN 22 1988
 CONSERVATION DIVISION
 Wichita, Kansas
 1-22-88

State Corporation Commission of Kansas
 Conservation Division
 200 Colorado Derby Building
 Wichita, Kansas 67202-1212
 (316) 263-3238