

CARD MUST BE TYPED

State of Kansas

CARD MUST BE SIGNED

NOTICE OF INTENTION TO DRILL

(see rules on reverse side)

Expected Spud Date..... MAY 18, 1988
month day year

API Number 15- 059-24,339-00-00 ✓

OPERATOR: License # 9873
Name PAINTER OIL COMPANY, INC.
Address P. O. BOX 141, RT. 2
City/State/Zip WELLSVILLE, KS 66092
Contact Person MAX PAINTER
Phone 901-685-7121

52 SE SE SE Sec. 33 Twp. 16 S, Rg. 20 East West
165 Ft. from South Line of Section
330 Ft. from East Line of Section

CONTRACTOR: License # 3417 3417
Name SIMPSON DRILLING
City/State OTTAWA, KS

(Note: Locate well on Section Plat on reverse side)
Nearest lease or unit boundary line 165 feet
County FRANKLIN
Lease Name HARRY SCOTT Well # 5

Well Drilled For: Well Class: Type Equipment:
 Oil Storage Infield Mud Rotary
 Gas Inj Pool Ext. Air Rotary
 OWWO Expl Wildcat Cable

Ground surface elevation feet MSL
Domestic well within 330 feet: yes no
Municipal well within one mile: yes no
Depth to bottom of fresh water.....
Depth to bottom of usable water 200

If OWWO: old well info as follows:
Operator
Well Name
Comp Date Old Total Depth.....

Surface pipe by Alternate: 1 2
Surface pipe planned to be set 40
Conductor pipe required
Projected Total Depth 800 feet
Formation..... SQUIRREL

I certify that well will comply with K.S.A. 55-101, et seq., plus eventually plugging hole to KCC specifications.
Date 5-18-88 Signature of Operator or Agent Greg Engleman Title AGENT

For KCC Use:
Conductor Pipe Required feet; Minimum Surface Pipe Required 20 feet per Alt. Y(2)
This Authorization Expires 11-18-88 Approved By 5-18-88


EFFECTIVE DATE: 5-23-88

Must be filed with the K.C.C. five (5) days prior to commencing well
 This card void if drilling not started within six (6) months of date received by K.C.C.

Important procedures to follow:

1. Notify District office before setting surface casing.
2. Set surface casing by circulating cement to the top.
3. File completion forms ACO-1 with K.C.C. within 120 days of well spud date, following instructions on ACO-1, side 1, and including copies of wireline logs.
4. Notify District office 48 hours prior to old well workover or re-entry.
5. Prior to filing Intent, prepare a proposed plugging plan in case well is D & A, then obtain approval of plan when calling district office prior to setting surface pipe.
6. Submit plugging report (CP-4) to K.C.C. after plugging is completed.
7. Obtain an approved injection docket number before disposing of salt water.
8. Notify K.C.C. within 10 days when injection commences or terminates.

A Regular Section of Land
1 Mile = 5,280 Ft.

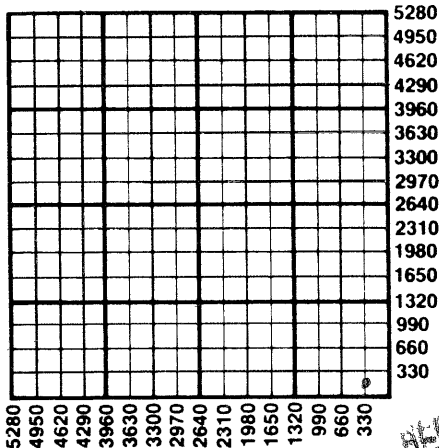

RECEIVED
 STATE CORPORATION COMMISSION

MAY 10 1988
 CONSERVATION DIVISION
 Wichita, Kansas

901 If an alternate 2 completion, cement in the production pipe from below any usable water to surface within 120 days of spud date.

State Corporation Commission of Kansas
 Conservation Division
 200 Colorado Derby Building
 Wichita, Kansas 67202-1212
 (316) 263-3238

5-18-88