

CARD MUST BE TYPED

State of Kansas

CARD MUST BE SIGNED

NOTICE OF INTENTION TO DRILL

(see rules on reverse side)

Expected Spud Date..... 9 month 30 day 1987 year

API Number 15- 059-24,267-00-00 East

OPERATOR: License # 4008

NW 1/4 Sec. 16 Twp. 16 S, Rg. 21 West

Name H. E. Barnett

5100 ft North Ft. from South Line of Section

Address Route 2 Box 54

4650 ft West Ft. from East Line of Section

City/State/Zip Wellsville, Ks. 66092

(Note: Locate well on Section Plat on reverse side)

Contact Person H. E. Barnett

Nearest lease or unit boundary line 600 feet

Phone 913-883-2473

County Franklin

CONTRACTOR: License # 6084

Lease Name Barnett Oil Well # C-4

Name McFullin Well Service

Ground surface elevation 820 feet MSL

City/State Wellsville, Ks.

Domestic well within 330 feet: yes no

Well Drilled For: Well Class: Type Equipment:

Municipal well within one mile: yes no

Oil Storage Infield Mud Rotary

Depth to bottom of fresh water 200 ft.

Gas Inj Pool Ext. Air Rotary

Depth to bottom of usable water 200 ft.

OWWO Expl Wildcat Cable

Surface pipe by Alternate: 1 2

If OWWO: old well info as follows:

Surface pipe planned to be set 21 ft.

Operator

Conductor pipe required

Well Name

Projected Total Depth 700 feet

Comp Date Old Total Depth

Formation Squirrel

I certify that well will comply with K.S.A. 55-101, et seq., plus eventually plugging hole to KCC specifications.

Date 9-16-87 Signature of Operator or Agent H. E. Barnett Title Operator

For KCC Use:

Conductor Pipe Required _____ feet; Minimum Surface Pipe Required 20 feet per Alt. X2


This Authorization Expires 3-21-88 Effective 9-26-87 Approved By H. E. Barnett #9-21-87

Must be filed with the K.C.C. five (5) days prior to commencing well
 This card void if drilling not started within six (6) months of date received by K.C.C.

Important procedures to follow:

1. Notify District office before setting surface casing.
2. Set surface casing by circulating cement to the top.
3. File completion forms ACO-1 with K.C.C. within 120 days of well spud date, following instructions on ACO-1, side 1, and including copies of wireline logs.
4. Notify District office 48 hours prior to old well workover or re-entry.
5. Prior to filing Intent, prepare a proposed plugging plan in case well is D & A, then obtain approval of plan when calling district office prior to setting surface pipe.
6. Submit plugging report (CP-4) to K.C.C. after plugging is completed.
7. Obtain an approved injection docket number before disposing of salt water.
8. Notify K.C.C. within 10 days when injection commences or terminates.
9. Alternate 2 completion, cement in the production pipe from low any usable water to surface within 120 days of spud date.

A Regular Section of Land
1 Mile = 5,280 Ft.

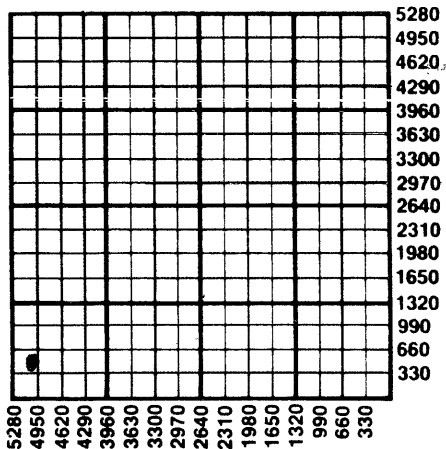

CONSERVATION DIVISION
 Wichita, Kansas

SEP 21 1987

RECEIVED
 STATE CORPORATION COMMISSION FOR EMISSION

State Corporation Commission of Kansas
 Conservation Division
 200 Colorado Derby Building
 Wichita, Kansas 67202-1212
 (316) 263-3238

9-21-87