

CARD MUST BE TYPED

State of Kansas
NOTICE OF INTENTION TO DRILL
(see rules on reverse side)

Extended to: 12-27-85
~~6-27-85~~ CARD MUST BE SIGNED

Starting Date: January 3 1985
month day year

API Number 15- 059-23,806-00-00

OPERATOR: License # 4008

NW 1 Sec .16 Twp .16 S, Rge .21 East West
(location)

Name Barnett, H. E.

Address Route 2, Box 54

4010 Ft North from Southeast Corner of Section

City/State/Zip Wellsville, Ks. 66092

4655 Ft West from Southeast Corner of Section

Contact Person H. E. Barnett

(Note: Locate well on Section Plat on reverse side)

Phone 913-883-2473

Nearest lease or unit boundary line 625 feet.

CONTRACTOR: License # 5335

County Franklin

Name Hawkeye Drilling Co., Inc.

Lease Name Barnett Well# G-1

City/State Wellsville, Kansas

Domestic well within 330 feet: yes no

Municipal well within one mile: yes no

Est. total depth 800 feet

Depth to Bottom of fresh water None feet

Lowest usable water formation Kansas City Group

Depth to Bottom of usable water 300-200 feet

Surface pipe by Alternate: 1 2

Surface pipe to be set 20 feet

Conductor pipe if any required _____ feet

Ground surface elevation _____ feet MSL

This Authorization Expires 6-27-85 12-27-85

Approved By REH/KCC 12-27-84

I certify that we will comply with K.S.A. 55-101, et seq., plus eventually plugging hole to K.C.C. specifications.

Date 12/24/84 Signature of Operator or Agent H. E. Barnett Title _____

MHC/KONE 12/27/84 Form C-1 4/84

Must be filed with the K.C.C. five (5) days prior to commencing well
 This card void if drilling not started within six (6) months of date received by K.C.C.


12-27-84

RECEIVED
 STATE CORPORATION COMMISSION
 DEC 27 1984

Important procedures to follow:

CONSERVATION DIVISION
 Wichita, Kansas

A Regular Section of Land
 1 Mile = 5,280 Ft.

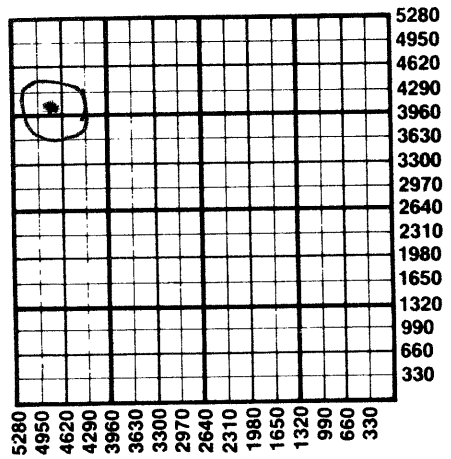

1. Notify District office before setting surface casing.
2. Set surface casing by circulating cement to the top.
3. File completion forms ACO-1 with K.C.C. within 90 days of well completion, following instructions on ACO-1, side 1, and including copies of wireline logs.
4. Notify District office 48 hours prior to old well workover or re-entry.
5. Prior to plugging, prepare a plugging plan, then obtain agreement from the appropriate district office for an approved plugging plan.
6. Submit plugging report (CP-4) to K.C.C. after plugging is completed.
7. Obtain an approved injection docket number before disposing of salt water.
8. Notify K.C.C. within 10 days when injection commences or terminates.
9. If an alternate 2 completion, cement in the production pipe from below any usable water to surface within 120 days of spud date.

State Corporation Commission of Kansas
 Conservation Division
 200 Colorado Derby Building
 Wichita, Kansas 67202
 (316) 263-3238