

CARD MUST BE TYPED

State of Kansas
NOTICE OF INTENTION TO DRILL
(see rules on reverse side)

CARD MUST BE SIGNED

Starting Date: September 24, 1984
month day year

API Number 15- 059-23,726-00-00

OPERATOR: License # 5959
Name Rader Oil Co.
Address R. R. #1
City/State/Zip Eudora, Kansas 66025
Contact Person Richard Rader
Phone 913-883-2885

SW NW NW
(location) Sec 17 Twp 16 S, Rge 21
 East
 West
4,615 Ft North from Southeast Corner of Section
5,105 Ft West from Southeast Corner of Section
(Note: Locate well on Section Plat on reverse side)

CONTRACTOR: License # 5820
Name M. J. Kent
City/State Garnett, Kansas

Nearest lease or unit boundary line 175 feet.
County Franklin
Lease Name Schlaegel Well# 6

Well Drilled For: Well Class: Type Equipment:
 Oil Swd Infield Mud Rotary
 Gas Inj Pool Ext. Air Rotary
 OWWO Expl Wildcat Cable

Domestic well within 330 feet: yes no
Municipal well within one mile: yes no

If OWWO: old well info as follows:
Operator
Well Name
Comp Date Old Total Depth
Projected Total Depth 700 feet
Projected Formation at TD
Expected Producing Formations

Depth to Bottom of fresh water none feet
Lowest usable water formation none
Depth to Bottom of usable water 200 feet
Surface pipe by Alternate: 1 2
Surface pipe to be set 21 feet
Conductor pipe if any required 0 feet
Ground surface elevation 990 feet MSL
This Authorization Expires 3-14-85
Approved By 9-14-84 RC

I certify that we will comply with K.S.A. 55-101, et seq., plus eventually plugging hole to K.C.C. specifications.


Date 9-12-84 Signature of Operator or Agent Title owner

mhc/RC 9/14/84 Form C-1 4/84

Must be filed with the K.C.C. five (5) days prior to commencing well
 This card void if drilling not started within six (6) months of date received by K.C.C.

Important procedures to follow :

A Regular Section of Land
1 Mile = 5,280 Ft.

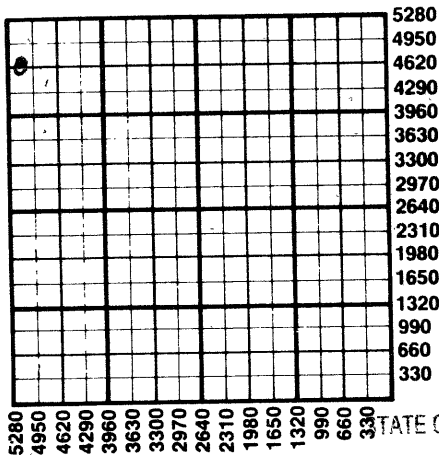

1. Notify District office before setting surface casing.
2. Set surface casing by circulating cement to the top.
3. File completion forms ACO-1 with K.C.C. within 90 days of well completion, following instructions on ACO-1, side 1, and including copies of wireline logs.
4. Notify District office 48 hours prior to old well workover or re-entry.
5. Prior to plugging, prepare a plugging plan, then obtain agreement from the appropriate district office for an approved plugging plan.
6. Submit plugging report (CP-4) to K.C.C. after plugging is completed.
7. Obtain an approved injection docket number before disposing of salt water.
8. Notify K.C.C. within 10 days when injection commences or terminates.
9. If an alternate 2 completion, cement in the production pipe from below any usable water to surface within 120 days of spud date.

RECEIVED

STATE CORPORATION COMMISSION

State Corporation Commission of Kansas
 Conservation Division
 200 Colorado Derby Building
 Wichita, Kansas 67202
 (316) 263-3238

G-14-84

SEP 14 1984

CONSERVATION DIVISION
 Wichita, Kansas