

CARD MUST BE TYPED

State of Kansas

CARD MUST BE SIGNED

NOTICE OF INTENTION TO DRILL

(see rules on reverse side)

* CORRECTION *

Expected Spud Date..... 08 21 86
month day year

API Number 15— 059-24, I 81 - 00-00 ✓
East

* OPERATOR: License # 6405
Name Richard Lamberd
Address R.R. # 2 Box 135
City/State/Zip Ottawa, Kansas 66067
Contact Person Richard Lamberd
Phone (913) 242-6805

App SE SE SE Sec. 36.. Twp.. 16 S, Rg... 20..
170
500
Ft. from South Line of Section
Ft. from East Line of Section

(Note: Locate well on Section Plat on reverse side)

Nearest lease or unit boundary line ... 165..... feet
County... Franklin

* CONTRACTOR: License # 5666
Name Finch's Drilling Inc.
City/State

Lease Name Lamberd Well # 7

* Ground surface elevation .. 900..... feet MSL

Well Drilled For: Well Class: Type Equipment:
 Oil Storage Infield Mud Rotary
 Gas Inj Pool Ext. Air Rotary
 OWWO Expl Wildcat Cable

Domestic well within 330 feet: — yes no

Municipal well within one mile: — yes no

Depth to bottom of fresh water... 200-60.....

Depth to bottom of usable water ... 200.....

Surface pipe by Alternate: 1 ___ 2 ___

Surface pipe planned to be set ... 200 21.....

Conductor pipe required

Projected Total Depth . 900..... feet

Formation ... Squirrel

If OWWO: old well info as follows:

Operator ..
Well Name ..
Comp Date .. Old Total Depth ..

I certify that well will comply with K.S.A. 55-101, et seq., plus eventually plugging hole to KCC specifications.

Date .. Signature of Operator or Agent Richard A. Lamberd Title owner-operator

For KCC Use:

Conductor Pipe Required .. feet; Minimum Surface Pipe Required .. 21 .. feet per Alt. X (2)

This Authorization Expired 2-18-87 Approved By R.A. 3-11-88

* Operator was Finch's Drilling, Contractor Unknown
Elevation N/A


ORIB. REV'D 8-18-86

Must be filed with the K.C.C. five (5) days prior to commencing well
This card void if drilling not started within six (6) months of date received by K.C.C.

Important procedures to follow:

1. Notify District office before setting surface casing.
2. Set surface casing by circulating cement to the top.
3. File completion forms ACO-1 with K.C.C. within 120 days of well spud date, following instructions on ACO-1, side 1, and including copies of wireline logs.
4. Notify District office 48 hours prior to old well workover or re-entry.
5. Prior to filing Intent, prepare a proposed plugging plan in case well is D & A, then obtain approval of plan when calling district office prior to setting surface pipe.
6. Submit plugging report (CP-4) to K.C.C. after plugging is completed.
7. Obtain an approved injection docket number before disposing of salt water.
8. Notify K.C.C. within 10 days when injection commences or terminates.
9. If an alternate 2 completion, cement in the production pipe from below any usable water to surface within 120 days of spud date.

A Regular Section of Land
1 Mile = 5,280 Ft.

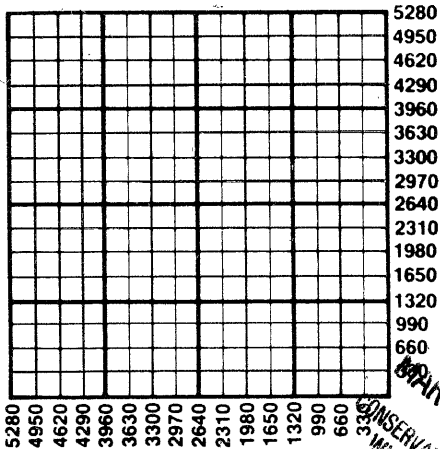

State Corporation Commission of Kansas
Conservation Division
200 Colorado Derby Building
Wichita, Kansas 67202-1212
(316) 263-3238

3-10-88