

CARD MUST BE TYPED

State of Kansas
NOTICE OF INTENTION TO DRILL
(see rules on reverse side)

CARD MUST BE SIGNED

Starting Date: June 20, 1985
month day year *S. 15*

API Number 15- *059-23,937-00-00*

OPERATOR: License # 8389
Name Greenwood Resources Inc.
Address 315 Inverness Way South
City/State/Zip Englewood, CO 80112
Contact Person Poul E. Poulsen
Phone 303-790-1266

NE... NE... SW Sec 30... Twp 15... S, Rge 21...
(location) East West

2090..... Ft North from Southeast Corner of Section

3140..... Ft West from Southeast Corner of Section

(Note: Locate well on Section Plat on reverse side)

CONTRACTOR: License # 5666
Name Finch Drilling Inc.
City/State Rt. 2 Box 125, Ottawa, KS 66067

Nearest lease or unit boundary line 500 feet.

County Franklin

Lease Name Wiseman Well# 15-L

Domestic well within 330 feet: yes no

Municipal well within one mile: yes no

Well Drilled For: Well Class: Type Equipment:
 Oil Swd Infield Mud Rotary
 Gas Inj Pool Ext. Air Rotary
 OWWO Expl Wildcat Cable

Depth to Bottom of fresh water *260* feet

Lowest usable water formation Lansing

Depth to Bottom of usable water *170* *200* feet

Surface pipe by Alternate: 1 2

Surface pipe to be set 20 feet

Conductor pipe if any required N/A feet

Ground surface elevation feet MSL

This Authorization Expires *12-18-85*

Approved By *6-18-85* *PC*

I certify that we will comply with K.S.A. 55-101, et seq., plus eventually plugging hole to K.C.C. specifications.

Date *6/19/85* Signature of Operator or Agent *Poul E. Poulsen* Title *MHC/NOHE 6-18-85* Engineer

RECEIVED
STATE CORPORATION COMMISSION


Must be filed with the K.C.C. five (5) days prior to commencing well
This card void if drilling not started within six (6) months of date received by K.C.C.

JUN 18 1985

6-18-PS

CONSERVATION DIVISION
Wichita, Kansas

A Regular Section of Land
1 Mile = 5,280 Ft.

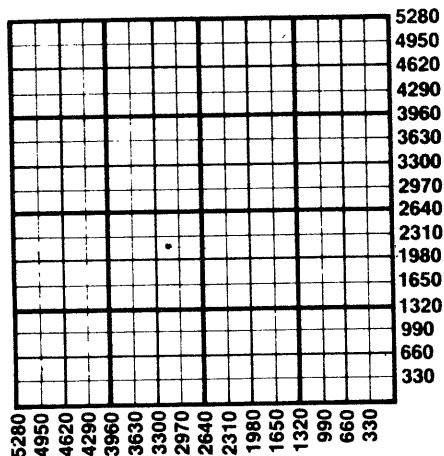

Important procedures to follow :

1. Notify District office before setting surface casing.
2. Set surface casing by circulating cement to the top.
3. File completion forms ACO-1 with K.C.C. within 90 days of well completion, following instructions on ACO-1, side 1, and including copies of wireline logs.
4. Notify District office 48 hours prior to old well workover or re-entry.
5. Prior to plugging, prepare a plugging plan, then obtain agreement from the appropriate district office for an approved plugging plan.
6. Submit plugging report (CP-4) to K.C.C. after plugging is completed.
7. Obtain an approved injection docket number before disposing of salt water.
8. Notify K.C.C. within 10 days when injection commences or terminates.
9. If an alternate 2 completion, cement in the production pipe from below any usable water to surface within 120 days of spud date.

State Corporation Commission of Kansas
Conservation Division
200 Colorado Derby Building
Wichita, Kansas 67202
(316) 263-3238