

CARD MUST BE TYPED

State of Kansas
NOTICE OF INTENTION TO DRILL
(see rules on reverse side)

CARD MUST BE SIGNED

Starting Date: August 21 1985
month day year

API Number 15-059-24,012-00-00

OPERATOR: License # 8389
Name Greenwood Resources Inc.
Address 315 Inverness Way South
City/State/Zip Englewood, CO 80112
Contact Person Poul E. Poulsen
Phone 303-790-1266

NW NE SW Sec 30 Twp 15 S, Rge 21
(location) East West

2520 Ft North from Southeast Corner of Section
3330 Ft West from Southeast Corner of Section
(Note: Locate well on Section Plat on reverse side)

CONTRACTOR: License # 5956
Name Gary Jackson Drilling Co.
City/State Rt. 3, Iola, KS 66749

Nearest lease or unit boundary line 690 feet.
County Franklin
Lease Name Wiseman Well# 16K

Well Drilled For: Well Class: Type Equipment:
 Oil Swd Infield Mud Rotary
 Gas Inj Pool Ext. Air Rotary
 OWWO Expl Wildcat Cable

Domestic well within 330 feet: yes no
Municipal well within one mile: yes no

If OWWO: old well info as follows:

Operator
Well Name
Comp Date Old Total Depth
Projected Total Depth 850 feet
Projected Formation at TD Cherokee
Expected Producing Formations Squirrel

Depth to Bottom of fresh water 60 feet
Lowest usable water formation Lansing Group
Depth to Bottom of usable water 200 feet
Surface pipe by Alternate: 1 2
Surface pipe to be set 20 feet
Conductor pipe if any required N/A feet
Ground surface elevation feet MSL
This Authorization Expires 2-6-86
Approved By 8-6-85 RCH BKDHE

I certify that we will comply with K.S.A. 55-101, et seq., plus eventually plugging hole to K.C.C. specifications.

Date 7/24/85 Signature of Operator or Agent

Poul E. Poulsen


Title Engineer

Must be filed with the K.C.C. five (5) days prior to commencing well
 This card void if drilling not started within six (6) months of date received by K.C.C.

RECEIVED
 STATE CORPORATION COMMISSION

Important procedures to follow: **APR 29 1965**

A Regular Section of Land
1 Mile = 5,280 Ft.

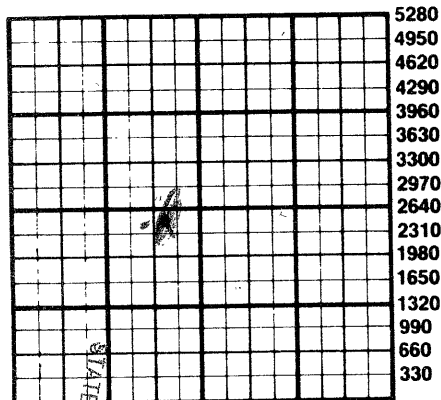

1. Notify District office before setting surface casing. CONSERVATION DIVISION
Wichita, Kansas
2. Set surface casing by circulating cement to the top.
3. File completion forms ACO-1 with K.C.C. within 90 days of well completion, following instructions on ACO-1, side 1, and including copies of wireline logs.
4. Notify District office 48 hours prior to old well workover or re-entry.
5. Prior to plugging, prepare a plugging plan, then obtain agreement from the appropriate district office for an approved plugging plan.
6. Submit plugging report (CP-4) to K.C.C. after plugging is completed.
7. Obtain an approved injection docket number before disposing of salt water.
8. Notify K.C.C. within 10 days when injection commences or terminates.
9. If an alternate 2 completion, cement in the production pipe from below any usable water to surface within 120 days of spud date.

State Corporation Commission of Kansas
 Conservation Division
 200 Colorado Derby Building
 Wichita, Kansas 67202
 (316) 263-3238

8-5-85

CONSERVATION DIVISION
 WICHITA, KANSAS

APR 29 1965

RECEIVED
 STATE CORPORATION COMMISSION