

CARD MUST BE TYPED

State of Kansas

CARD MUST BE SIGNED

NOTICE OF INTENTION TO DRILL

(see rules on reverse side)

Starting Date October 25, 1985
month day year 3:45

API Number 15— 059-24,090-00-00

OPERATOR: License # 9950 app. SW..SW..NW Sec. 5 Twp. 16 S, Rg. 24 East
Name Ron-Mar Energy Exploration Inc. 3.135 Ft. from South Line of Section — West
Address 2210 W. 75th St. 51.15 Ft. from East Line of Section
City/State/Zip Shawnee Mission, KS 66208
Contact Person John F. Roney
Phone 913-362-2121

(Note: Locate well on Section Plat on reverse side)

CONTRACTOR: License # 5335
Name Hawkeye Drilling Co.,
City/State Wellsville, KS 66092

Nearest lease or unit boundary 165 feet
County Franklin
Lease Name O'Conner Well # 7
Ground surface elevation feet MSL
Domestic well within 330 feet: — yes no
Municipal well within one mile: — yes no
Surface pipe by Alternate: 1 2
Depth to bottom of fresh water 106
Depth to bottom of usable water 200
Surface pipe planned to be set 20
Projected Total Depth 700 feet
Formation Squirrel

Well Drilled For: Well Class: Type Equipment:
 Oil SWD Infield Mud Rotary
 Gas Inj Pool Ext. Air Rotary
 OWWO Expl Wildcat Cable

If OWWO: old well info as follows:
Operator
Well Name
Comp Date Old Total Depth

I certify that well will comply with K.S.A. 55-101, et seq., plus eventually plugging hole to KCC specifications.

 cementing will be done immediately upon setting production casing.
Date 10/25/85 Signature of Operator or Agent Susan Arnold Title As. Agent

Handwritten signature/initials

For KCC Use:
Conductor Pipe Required feet; Minimum Surface Pipe Required feet per Alt. 2
This Authorization Expires 4-24-86 Approved By 10-24-85

Handwritten signature/initials

Must be filed with the K.C.C. five (5) days prior to commencing well
 This card void if drilling not started within six (6) months of date received by K.C.C.

1024-85

Important procedures to follow:


RECEIVED
 STATE CORPORATION COMMISSION

A Regular Section of Land
 1 Mile = 5,280 Ft.

OCT 24 1985

1. Notify District office before setting surface casing.
2. Set surface casing by circulating cement to the top.
3. File completion forms ACO-1 with K.C.C. within 90 days of well completion, following instructions on ACO-1, side 1, and including copies of wireline logs.
4. Notify District office 48 hours prior to old well workover or re-entry.
5. Prior to filing Intent, prepare a proposed plugging plan in case well is D & A, then obtain approval of plan when calling district office prior to setting surface pipe.
6. Submit plugging report (CP-4) to K.C.C. after plugging is completed.
7. Obtain an approved injection docket number before disposing of salt water.
8. Notify K.C.C. within 10 days when injection commences or terminates.
9. If an alternate 2 completion, cement in the production pipe from below any usable water to surface within 120 days of spud date.

CONSERVATION DIVISION
 Wichita, Kansas

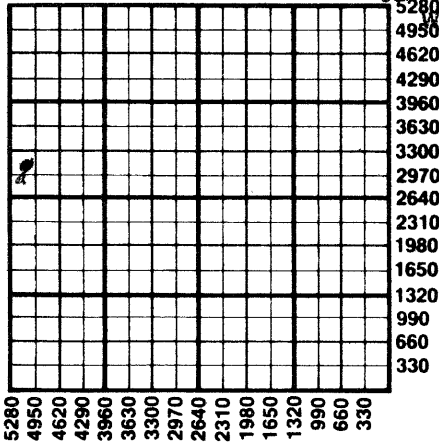

State Corporation Commission of Kansas
 Conservation Division
 200 Colorado Derby Building
 Wichita, Kansas 67202
 (316) 263-3238