

CARD MUST BE TYPED

State of Kansas

CARD MUST BE SIGNED

NOTICE OF INTENTION TO DRILL

(see rules on reverse side)

Starting Date March 26, 1986
month day year *J. 45*

API Number 15— *059-24,161-00-00*
X ___ East

OPERATOR: License # 9233

App. NE SE NE Sec. 6 Twp. 16 S, Rg. 21 West

Name Midland Enterprises, Inc.

..... 3795 Ft. from South Line of Section

Address 935 Sunset

..... 165 Ft. from East Line of Section

City/State/Zip Lawrence, KS 66044

(Note: Locate well on Section Plat on reverse side)

Contact Person Jonathan Garrett

Nearest lease or unit boundary line 165 feet

Phone 913 841 6219

County Franklin

CONTRACTOR: License # 6807

Lease Name. O'Connor Well # ... 1-86

Name Oil Drillers & Dev., Inc.

Ground surface elevation feet MSL

City/State Topeka, KS 66614

Domestic well within 330 feet: _____ yes no

Well Drilled For: Well Class: Type Equipment:

Municipal well within one mile: _____ yes no

Oil _____ SWD _____ Infield _____ Mud Rotary

Depth to bottom of fresh water 25

_____ Gas _____ Inj Pool Ext. _____ Air Rotary

Depth to bottom of usable water 200

_____ OWWO _____ Expl _____ Wildcat _____ Cable

Surface pipe by Alternate: 1 _____ 2

If OWWO: old well info as follows:

Surface pipe planned to be set 20

Operator

Conductor pipe required 800

Well Name

Projected Total Depth Lower Squirrel feet

Comp Date Old Total Depth

Formation

I certify that well will comply with K.S.A. 55-101, et seq., plus eventually plugging hole to KCC specifications.

Date .. 3/25/86 Signature of Operator or Agent *Clarence Jackson* Title as agent

For KCC Use:

Conductor Pipe Required feet; Minimum Surface Pipe Required feet per Alt. *20*


This Authorization Expires *9-25-86* Approved By *9-25-86* *RCH/10/86*

Must be filed with the K.C.C. five (5) days prior to commencing well
 This card void if drilling not started within six (6) months of date received by K.C.C.

Important procedures to follow:

1. Notify District office before setting surface casing.
2. Set surface casing by circulating cement to the top.
3. File completion forms ACO-1 with K.C.C. within 90 days of well completion, following instructions on ACO-1, side 1, and including copies of wireline logs.
4. Notify District office 48 hours prior to old well workover or re-entry.
5. Prior to filing Intent, prepare a proposed plugging plan in case well is D & A, then obtain approval of plan when calling district office prior to setting surface pipe.
6. Submit plugging report (CP-4) to K. C. C. after plugging is completed.
7. Obtain an approved injection docket number before disposing of salt water.
8. Notify K.C.C. within 10 days when injection commences or terminates.

A Regular Section of Land
1 Mile = 5,280 Ft.

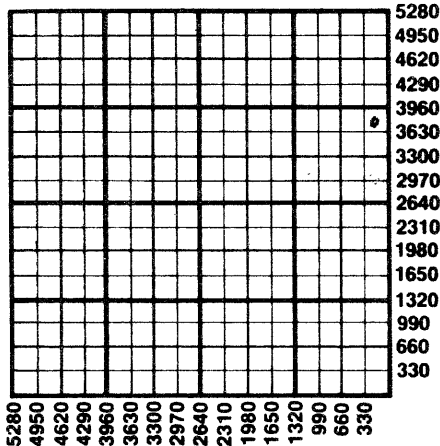

RECEIVED
 STATE CORPORATION COMMISSION
 If an alternate 2 completion, cement in the production pipe from below any usable water to surface within 120 days of spud date.

3-25-86

MAR 25 1986

CONSERVATION DIVISION
 Wichita, Kansas

State Corporation Commission of Kansas
 Conservation Division
 200 Colorado Derby Building
 Wichita, Kansas 67202
 (316) 263-3238