

CARD MUST BE TYPED

State of Kansas
NOTICE OF INTENTION TO DRILL
(see rules on reverse side)

CARD MUST BE SIGNED

Starting Date: September 20, 1984
month day year

API Number 15- 059-23,728-00-00

OPERATOR: License # 5959
Name Rader Oil Co.
Address R. R. #1
City/State/Zip Eudora, Kansas 66025
Contact Person Richard Rader
Phone 913-883-2885

NW SE SE Sec 7 Twp 16 S, Rge 21
(location) East West

665 Ft North from Southeast Corner of Section
1,173 Ft West from Southeast Corner of Section
(Note: Locate well on Section Plat on reverse side)

CONTRACTOR: License # 5820
Name M. J. Kent (Kant. Drig.)
City/State Garnett, Kansas

Nearest lease or unit boundary line 665 feet.
County Franklin
Lease Name Stephens Well# 18

Domestic well within 330 feet: yes no
Municipal well within one mile: yes no

Well Drilled For: Well Class: Type Equipment:
 Oil Swd Infield Mud Rotary
 Gas Inj Pool Ext. Air Rotary
 OWWO Expl Wildcat Cable

Depth to Bottom of fresh water none feet
Lowest usable water formation 200e feet
Depth to Bottom of usable water 200 feet
Surface pipe by Alternate: 1 2
Surface pipe to be set 21 feet
Conductor pipe if any required 0 feet
Ground surface elevation 970 feet MSL

If OWWO: old well info as follows:
Operator
Well Name
Comp Date Old Total Depth
Projected Total Depth 700 feet
Projected Formation at TD
Expected Producing Formations

This Authorization Expires 3-14-85
Approved By 9-14-84 [Signature]

I certify that we will comply with K.S.A. 55-101, et seq., plus eventually plugging hole to K.C.C. specifications.

Date 9-12-84 Signature of Operator or Agent [Signature]


Title owner

with HOME 9/14/84

Must be filed with the K.C.C. five (5) days prior to commencing well
 This card void if drilling not started within six (6) months of date received by K.C.C.

Important procedures to follow :

A Regular Section of Land
1 Mile = 5,280 Ft.

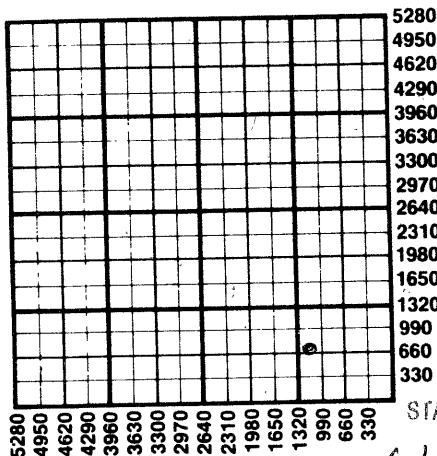

1. Notify District office before setting surface casing.
2. Set surface casing by circulating cement to the top.
3. File completion forms ACO-1 with K.C.C. within 90 days of well completion, following instructions on ACO-1, side 1, and including copies of wireline logs.
4. Notify District office 48 hours prior to old well workover or re-entry.
5. Prior to plugging, prepare a plugging plan, then obtain agreement from the appropriate district office for an approved plugging plan.
6. Submit plugging report (CP-4) to K.C.C. after plugging is completed.
7. Obtain an approved injection docket number before disposing of salt water.
8. Notify K.C.C. within 10 days when injection commences or terminates.
9. If an alternate 2 completion, cement in the production pipe from below the last usable water to surface within 120 days of spud date.

RECEIVED
 STATE CORPORATION COMMISSION

9-14-84

SEP 14 1984

State Corporation Commission of Kansas
 Conservation Division
 200 Colorado Derby Building
 Wichita, Kansas 67202
 (316) 263-3238

CONSERVATION DIVISION
 Wichita, Kansas