

CARD MUST BE TYPED

State of Kansas **NOTICE OF INTENTION TO DRILL** (see rules on reverse side)

CARD MUST BE SIGNED

Starting Date: December 19, 1984
 month day year

API Number 15- 059-23,794-00-00

OPERATOR: License # 5959
 Name Rader Oil Co.
 Address R. R. #1
 City/State/Zip Eudora, Kansas 66025
 Contact Person Richard Rader
 Phone 913-883-2885

CONTRACTOR: License # 5820
 Name M. J. Kent
 City/State Garnett, Kansas

Well Drilled For:

Well Class:

Type Equipment:

☒ Oil ☐ Swd
☐ Gas ☐ Inj
☐ OWWO ☐ Expl

☐ Infield
☒ Pool Ext.
☐ Wildcat

☒ Mud Rotary
☐ Air Rotary
☐ Cable

If OWWO: old well info as follows:

Operator
 Well Name
 Comp Date Old Total Depth
 Projected Total Depth 750 feet
 Projected Formation at TD Squirrel
 Expected Producing Formations

I certify that we will comply with K.S.A. 55-101, et seq., plus eventually plugging hole to K.C.C. specifications.

Date 12-10-84

Signature of Operator or Agent

Richard Rader

Title

Owner

SE NE NE Sec 18 Twp 16 S, Rge 21 ☒ East
 (location) ☐ West

4092 Ft North from Southeast Corner of Section
 495 Ft West from Southeast Corner of Section
 (Note: Locate well on Section Plat on reverse side)

Nearest lease or unit boundary line 495 feet.

County Franklin

Lease Name McConnell Well# 30

Domestic well within 330 feet: ☐ yes ☒ no

Municipal well within one mile: ☐ yes ☒ no

Depth to Bottom of fresh water none feet

Lowest usable water formation none

Depth to Bottom of usable water 200 feet

Surface pipe by Alternate: 1 ☐ 2 ☒

Surface pipe to be set 20 feet

Conductor pipe if any required 0 feet

Ground surface elevation 990 feet MSL

This Authorization Expires 6-13-85


Approved By 12-13-84

MHC/KOHE 12-13-84

**Must be filed with the K.C.C. five (5) days prior to commencing well
This card void if drilling not started within six (6) months of date received by K.C.C.**

Important procedures to follow:

**A Regular Section of Land
1 Mile = 5,280 Ft.**

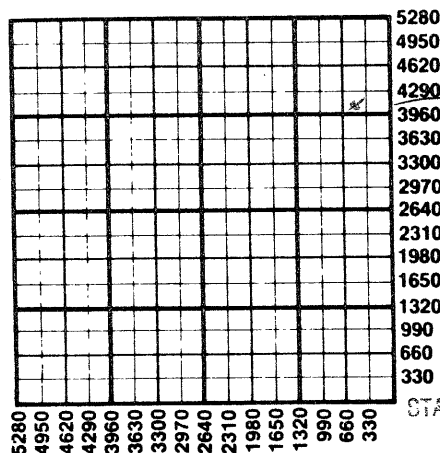

1. Notify District office before setting surface casing.
2. Set surface casing by circulating cement to the top.
3. File completion forms ACO-1 with K.C.C. within 90 days of well completion, following instructions on ACO-1, side 1, and including copies of wireline logs.
4. Notify District office 48 hours prior to old well workover or re-entry.
5. Prior to plugging, prepare a plugging plan, then obtain agreement from the appropriate district office for an approved plugging plan.
6. Submit plugging report (CP-4) to K.C.C. after plugging is completed.
7. Obtain an approved injection docket number before disposing of salt water.
8. Notify K.C.C. within 10 days when injection commences or terminates.
9. If an alternate 2 completion, cement in the production pipe from below any usable water to surface within 120 days of spud date.

RECEIVED
STATE CORPORATION COMMISSION

State Corporation Commission of Kansas

Conservation Division

200 Colorado Derby Building

Wichita, Kansas 67202

(316) 263-3238

CONSERVATION DIVISION
Wichita, Kansas

12-13-84 DEC 13 1984