

CARD MUST BE TYPED

State of Kansas

CARD MUST BE SIGNED

NOTICE OF INTENTION TO DRILL

(see rules on reverse side)

Starting Date month day year

API Number 15— 059-24150-00-00

OPERATOR: License # 6142

SW Sec. 18 Twp. 16 S, Rg. 21 X East

Name Town Oil Co.

2145 West

Address Rt. 4

3465 Ft. from South Line of Section

City/State/Zip Paola, KS. 66071

..... Ft. from East Line of Section

Contact Person Lester Town

(Note: Locate well on Section Plat on reverse side)

Phone 913 294-2125

Nearest lease or unit boundary line 825 feet

CONTRACTOR: License # 6142

County Franklin

Name COMPANY TOOLS

Lease Name Bivins Well # 7

City/State

Ground surface elevation feet MSL

Well Drilled For: Well Class: Type Equipment:

Domestic well within 330 feet: yes X no

X Oil SWD X Infield X Mud Rotary

Municipal well within one mile: yes X no

Gas Inj Pool Ext. Air Rotary

Depth to bottom of fresh water 0 20

OWWO Expl Wildcat Cable

Depth to bottom of usable water 300 200

If OWWO: old well info as follows:

Surface pipe by Alternate: 1 2 X

Operator

Surface pipe planned to be set 20

Well Name

Conductor pipe required none

Comp Date Old Total Depth.....

Projected Total Depth 750 feet

I certify that well will comply with K.S.A. 55-101, et seq., plus eventually plugging hole to KCC specifications.

Formation Bartlesville

Date 1-24-86 Signature of Operator or Agent Lester Town Title Partner

For KCC Use:

Conductor Pipe Required feet; Minimum Surface Pipe Required 20 feet per Alt. X


This Authorization Expires 7-29-86 Approved By 1-29-86 R

Must be filed with the K.C.C. five (5) days prior to commencing well
This card void if drilling not started within six (6) months of date received by K.C.C.

Important procedures to follow:

1. Notify District office before setting surface casing.
2. Set surface casing by circulating cement to the top.
3. File completion forms ACO-1 with K.C.C. within 90 days of well completion, following instructions on ACO-1, side 1, and including copies of wireline logs.
4. Notify District office 48 hours prior to old well workover or re-entry.
5. Prior to filing Intent, prepare a proposed plugging plan in case well is D & A, then obtain approval of plan when calling district office prior to setting surface pipe.
6. Submit plugging report (CP-4) to K.C.C. after plugging is completed.
7. Obtain an approved injection docket number before disposing of salt water.
8. Notify K.C.C. within 10 days when injection commences or terminates.
9. If an alternate 2 completion, cement in the production pipe from below any usable water to surface within 120 days of spud date.

A Regular Section of Land
1 Mile = 5,280 Ft.

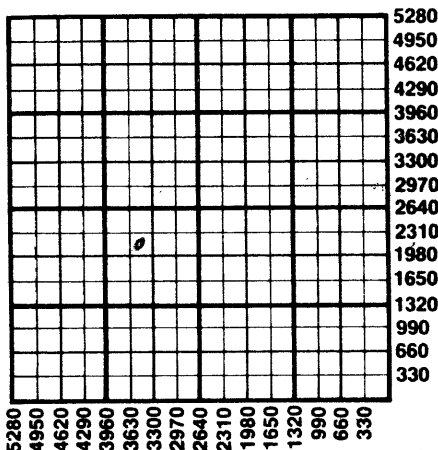

STATE CORPORATION COMMISSION

JAN 29 1983

CONSERVATION DIVISION
Wichita, Kansas

State Corporation Commission of Kansas
Conservation Division
200 Colorado Derby Building
Wichita, Kansas 67202
(316) 263-3238

1-29-86