

CARD MUST BE TYPED

State of Kansas
NOTICE OF INTENTION TO DRILL
(see rules on reverse side)

CARD MUST BE SIGNED

Starting Date: October 25, 1984
month day year

API Number 15- 059-23,763-00-00

OPERATOR: License # 5959
Name Rader Oil Co.
Address R. R. #1
City/State/Zip Eudora, Kansas 66025
Contact Person Richard Rader
Phone 913-883-2885

NW SE NW Sec 20 Twp 16 S, Rge 21 East West
(location)
3826 Ft North from Southeast Corner of Section
3520 Ft West from Southeast Corner of Section
(Note: Locate well on Section Plat on reverse side)

CONTRACTOR: License # 5820
Name M. J. Kent
City/State Garnett, Kansas 66032

Nearest lease or unit boundary line 880 feet.
County Franklin
Lease Name Olson Well# 15

Well Drilled For: Well Class: Type Equipment:
 Oil Swd Infield Mud Rotary
 Gas Inj Pool Ext. Air Rotary
 OWWO Expl Wildcat Cable

Domestic well within 330 feet: yes no
Municipal well within one mile: yes no

If OWWO: old well info as follows:

Operator
Well Name
Comp Date Old Total Depth
Projected Total Depth 725 feet
Projected Formation at TD Squirrel
Expected Producing Formations

Depth to Bottom of fresh water none feet
Lowest usable water formation none
Depth to Bottom of usable water 200 feet
Surface pipe by Alternate : 1 2
Surface pipe to be set 20 feet
Conductor pipe if any required 0 feet
Ground surface elevation 960 feet MSL
This Authorization Expires 4-18-85
Approved By 10-18-84 *R*

I certify that we will comply with K.S.A. 55-101, et seq., plus eventually plugging hole to K.C.C. specifications.

Date 10-16-84 Signature of Operator or Agent

Richard Rader

Title

MHC/WOHE 10/18/84
Owner

Must be filed with the K.C.C. five (5) days prior to commencing well
 This card void if drilling not started within six (6) months of date received by K.C.C.

10-18-84


RECEIVED
 STATE CORPORATION COMMISSION

Important procedures to follow:

OCT 18 1984

CONSERVATION DIVISION
 Wichita, Kansas

**A Regular Section of Land
 1 Mile = 5,280 Ft.**

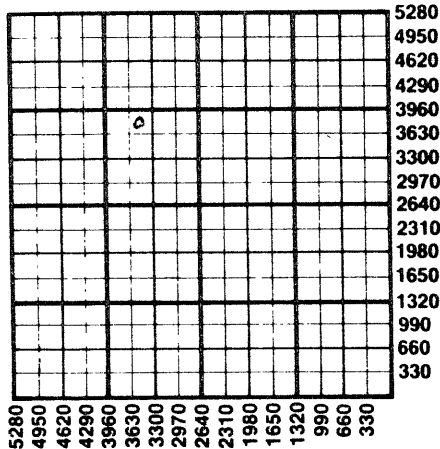

1. Notify District office before setting surface casing.
2. Set surface casing by circulating cement to the top.
3. File completion forms ACO-1 with K.C.C. within 90 days of well completion, following instructions on ACO-1, side 1, and including copies of wireline logs.
4. Notify District office 48 hours prior to old well workover or re-entry.
5. Prior to plugging, prepare a plugging plan, then obtain agreement from the appropriate district office for an approved plugging plan.
6. Submit plugging report (CP-4) to K.C.C. after plugging is completed.
7. Obtain an approved injection docket number before disposing of salt water.
8. Notify K.C.C. within 10 days when injection commences or terminates.
9. If an alternate 2 completion, cement in the production pipe from below any usable water to surface within 120 days of spud date.

State Corporation Commission of Kansas
 Conservation Division
 200 Colorado Derby Building
 Wichita, Kansas 67202
 (316) 263-3238