

CARD MUST BE TYPED

# NOTICE OF INTENTION TO DRILL

State of Kansas  
(see rules on reverse side)

CARD MUST BE SIGNED

Starting Date: October 23, 1984  
month day year

API Number 15- 059-23,761-00-00

OPERATOR: License # 5959  
Name Rader Oil Co.  
Address R. R. #1  
City/State/Zip Eudora, Kansas 66025  
Contact Person Richard Rader  
Phone 913-883-2885

NW  NE  SW  SE Sec 20 Twp 16 S, Rge 21  East  West  
(location)

4682 Ft North from Southeast Corner of Section  
3520 Ft West from Southeast Corner of Section  
(Note: Locate well on Section Plat on reverse side)

CONTRACTOR: License # 5820  
Name M. J. Kent  
City/State Garnett, Kansas 66032

Nearest lease or unit boundary line 598 feet.

County Franklin

Lease Name Oison Well# 13

Domestic well within 330 feet:  yes  no

Municipal well within one mile:  yes  no

Well Drilled For: Well Class: Type Equipment:  
 Oil  Swd  Infield  Mud Rotary  
 Gas  Inj  Pool Ext.  Air Rotary  
 OWWO  Expl  Wildcat  Cable

Depth to Bottom of fresh water ..... none ..... feet

Lowest usable water formation ..... none ..... feet

Depth to Bottom of usable water ..... 200 ..... feet

Surface pipe by Alternate: 1  2

Surface pipe to be set ..... 20 ..... feet

Conductor pipe if any required ..... 0 ..... feet

Ground surface elevation ..... 960 ..... feet MSL

This Authorization Expires 4-18-85

Approved By 10-18-84 *RC*

I certify that we will comply with K.S.A. 55-101, et seq., plus eventually plugging hole to K.C.C. specifications.

Date 10-16-84 Signature of Operator or Agent *Richard Rader*


Title Owner *MHC/WHHE 10/16/84*

Must be filed with the K.C.C. five (5) days prior to commencing well  
 This card void if drilling not started within six (6) months of date received by K.C.C.

1078-84  
 RECEIVED  
 STATE CORPORATION COMMISSION  
 OCT 18 1984

**Important procedures to follow:**

**A Regular Section of Land  
 1 Mile = 5,280 Ft.**

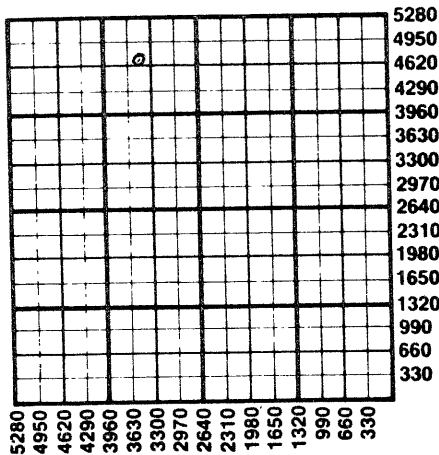

1. Notify District office before setting surface casing.
2. Set surface casing by circulating cement to the top.
3. File completion forms ACO-1 with K.C.C. within 90 days of well completion, following instructions on ACO-1, side 1, and including copies of wireline logs.
4. Notify District office 48 hours prior to old well workover or re-entry.
5. Prior to plugging, prepare a plugging plan, then obtain agreement from the appropriate district office for an approved plugging plan.
6. Submit plugging report (CP-4) to K.C.C. after plugging is completed.
7. Obtain an approved injection docket number before disposing of salt water.
8. Notify K.C.C. within 10 days when injection commences or terminates.
9. If an alternate 2 completion, cement in the production pipe from below any usable water to surface within 120 days of spud date.

CONSERVATION DIVISION  
 Wichita, Kansas

State Corporation Commission of Kansas  
 Conservation Division  
 200 Colorado Derby Building  
 Wichita, Kansas 67202  
 (316) 263-3238