

CARD MUST BE TYPED

State of Kansas
NOTICE OF INTENTION TO DRILL

CARD MUST BE SIGNED

(see rules on reverse side)

Starting Date: 7 13 85
month day year

API Number 15- 059-23,979-0000

OPERATOR: License # 6142

SE NW Sec 19 Twp 16 S, Rge 21 East
(location) West

Name Town Oil Co.

Address Rt. 4

City/State/Zip Paola, KS 66071

Contact Person Lester Town

Phone 913-294-2125

3545 Ft North from Southeast Corner of Section
3380 Ft West from Southeast Corner of Section
(Note: Locate well on Section Plat on reverse side)

CONTRACTOR: License # 6142

Name COMPANY TOOLS

City/State

Nearest lease or unit boundary line 1485 feet.

County Franklin

Lease Name Brown Well# 11

Domestic well within 330 feet: yes no

Municipal well within one mile: yes no

Well Drilled For: Well Class: Type Equipment:

- Oil Swd Infield Mud Rotary
- Gas Inj Pool Ext. Air Rotary
- OWWO Expl Wildcat Cable

Depth to Bottom of fresh water 0 275' feet

Lowest usable water formation

Depth to Bottom of usable water 200 200 feet

Surface pipe by Alternate: 1 2

Surface pipe to be set 20 feet

Conductor pipe if any required 0 feet

Ground surface elevation

This Authorization Expires 1-8-86

Approved By 7-8-85 RC

If OWWO: old well info as follows:

Operator

Well Name

Comp Date Old Total Depth

Projected Total Depth 700 feet

Projected Formation at TD Bartlesville

Expected Producing Formations Bartlesville

I certify that we will comply with K.S.A. 55-101, et seq., plus eventually plugging hole to K.C.C. specifications.

RCN for KDHE


Date 7-2-85 Signature of Operator or Agent Lester Town Title Partner

Must be filed with the K.C.C. five (5) days prior to commencing well
 This card void if drilling not started within six (6) months of date received by K.C.C.

7-8-85
 RECEIVED
 STATE CORPORATION COMMISSION
 JUL 08 1985
 CONSERVATION DIVISION
 WICHITA, KANSAS

Important procedures to follow:

**A Regular Section of Land
 1 Mile = 5,280 Ft.**

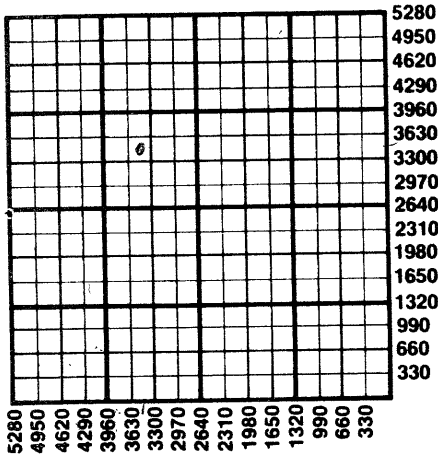

1. Notify District office before setting surface casing.
2. Set surface casing by circulating cement to the top.
3. File completion forms ACO-1 with K.C.C. within 90 days of well completion, following instructions on ACO-1, side 1, and including copies of wireline logs.
4. Notify District office 48 hours prior to old well workover or re-entry.
5. Prior to plugging, prepare a plugging plan, then obtain agreement from the appropriate district office for an approved plugging plan.
6. Submit plugging report (CP-4) to K.C.C. after plugging is completed.
7. Obtain an approved injection docket number before disposing of salt water.
8. Notify K.C.C. within 10 days when injection commences or terminates.
9. If an alternate 2 completion, cement in the production pipe from below any usable water to surface within 120 days of spud date.

**State Corporation Commission of Kansas
 Conservation Division
 200 Colorado Derby Building
 Wichita, Kansas 67202
 (316) 263-3238**