

CARD MUST BE TYPED

State of Kansas

CARD MUST BE SIGNED

### NOTICE OF INTENTION TO DRILL

(see rules on reverse side)

Starting Date ..... month day year

API Number 15- 059-24,152-00-00

OPERATOR: License # 6142

Name Town Oil Co.

Address Rt. 4

City/State/Zip Paola, KS. 66071

Contact Person Lester Town

Phone 913 294-2125

CONTRACTOR: License # 6142

Name COMPANY TOOLS

City/State .....

Well Drilled For: Well Class: Type Equipment:

Oil  SWD  Infield  Mud Rotary

Gas  Inj  Pool Ext.  Air Rotary

OWWO  Expl  Wildcat  Cable

If OWWO: old well info as follows:

Operator .....

Well Name .....

Comp Date ..... Old Total Depth .....

I certify that well will comply with K.S.A. 55-101, et seq., plus eventually plugging hole to KCC specifications.

Date 1-24-86 ... Signature of Operator or Agent L. Town ..... Title Partner .....

For KCC Use:

Conductor Pipe Required ..... feet; Minimum Surface Pipe Required ..... 20 feet per Alt. X 2

This Authorization Expires 7-29-86 ..... Approved By LC .....

APC N1/2 N1/2 NW Sec. 19 Twp. 16 S, Rg 21  East  West

4445 ..... Ft. from South Line of Section

2805 ..... Ft. from East Line of Section

(Note: Locate well on Section Plat on reverse side)

Nearest lease or unit boundary line 330 ~~300~~ ..... feet

County Franklin .....

Lease Name Brown ..... Well # 12 .....

Ground surface elevation ..... feet MSL

Domestic well within 330 feet:  yes  no

Municipal well within one mile:  yes  no

Depth to bottom of fresh water 0 20 .....

Depth to bottom of usable water 300 400 .....

Surface pipe by Alternate:  1  2  X

Surface pipe planned to be set ..... 20 .....

Conductor pipe required ..... none .....

Projected Total Depth ..... 700 ..... feet

Formation Bartlesville .....


fe#100HE

Must be filed with the K.C.C. five (5) days prior to commencing well  
 This card void if drilling not started within six (6) months of date received by K.C.C.

**Important procedures to follow:**

1. Notify District office before setting surface casing.
2. Set surface casing by circulating cement to the top.
3. File completion forms ACO-1 with K.C.C. within 90 days of well completion, following instructions on ACO-1, side 1, and including copies of wireline logs.
4. Notify District office 48 hours prior to old well workover or re-entry.
5. Prior to filing Intent, prepare a proposed plugging plan in case well is D & A, then obtain approval of plan when calling district office prior to setting surface pipe.
6. Submit plugging report (CP-4) to K.C.C. after plugging is completed.
7. Obtain an approved injection docket number before disposing of salt water.
8. Notify K.C.C. within 10 days when injection commences or terminates.
9. If an alternate 2 completion, cement in the production pipe from below any usable water to surface within 120 days of spud date.

**A Regular Section of Land  
 1 Mile = 5,280 Ft.**

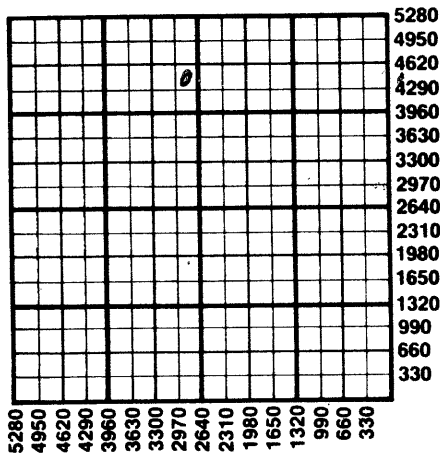

RECEIVED  
 STATE CORPORATION COMMISSION  
 1-21-86  
 JAN 29 1986

CONSERVATION DIVISION  
 WICHITA, KS 67202

State Corporation Commission of Kansas  
 Conservation Division  
 200 Colorado Derby Building  
 Wichita, Kansas 67202  
 (316) 263-3238