

CARD MUST BE TYPED

State of Kansas

CARD MUST BE SIGNED

NOTICE OF INTENTION TO DRILL

(see rules on reverse side)

Starting Date month day year

API Number 15— 059-24,153-00-00

OPERATOR: License # 6142

..... NE Sec. 19 Twp. 16 S, Rg. 21 X East

Name Town Oil Co.

..... 4005 Ft. from South Line of Section

Address Rt. 4

..... 2600 Ft. from East Line of Section

City/State/Zip Paola, KS. 66071

(Note: Locate well on Section Plat on reverse side)

Contact Person Lester Town

Nearest lease or unit boundary line 1275 feet

Phone 913 294-2125

County Franklin

CONTRACTOR: License # 6142

Lease Name.. Brown Well #.. 13

Name COMPANY TOOLS

Ground surface elevation feet MSL

City/State

Domestic well within 330 feet: yes X no

Well Drilled For: Well Class: Type Equipment:

Municipal well within one mile: yes X no

— Oil — SWD — Infield — Mud Rotary

Depth to bottom of fresh water 300 20

— Gas — Inj — Pool Ext. — Air Rotary

Depth to bottom of usable water 200

— OWWO — Expl — Wildcat — Cable

Surface pipe by Alternate: 1 2X

If OWWO: old well info as follows:

Surface pipe planned to be set 20

Operator

Conductor pipe required none

Well Name

Projected Total Depth 700 feet

Comp Date Old Total Depth

Formation Bartlesville

I certify that well will comply with K.S.A. 55-101, et seq., plus eventually plugging hole to KCC specifications.

Date 1-24-86 Signature of Operator or Agent Title Partner 2nd/none

For KCC Use:

Conductor Pipe Required feet; Minimum Surface Pipe Required 20 feet per Alt. X 2


This Authorization Expires 7-29-86 Approved By 1-29-86

Must be filed with the K.C.C. five (5) days prior to commencing well
This card void if drilling not started within six (6) months of date received by K.C.C.

Important procedures to follow:

1. Notify District office before setting surface casing.
2. Set surface casing by circulating cement to the top.
3. File completion forms ACO-1 with K.C.C. within 90 days of well completion, following instructions on ACO-1, side 1, and including copies of wireline logs.
4. Notify District office 48 hours prior to old well workover or re-entry.
5. Prior to filing Intent, prepare a proposed plugging plan in case well is D & A, then obtain approval of plan when calling district office prior to setting surface pipe.
6. Submit plugging report (CP-4) to K. C. C. after plugging is completed.
7. Obtain an approved injection docket number before disposing of salt water.
8. Notify K.C.C. within 10 days when injection commences or terminates.
9. If an alternate 2 completion, cement in the production pipe from below any usable water to surface within 120 days of spud date.

A Regular Section of Land
1 Mile = 5,280 Ft.

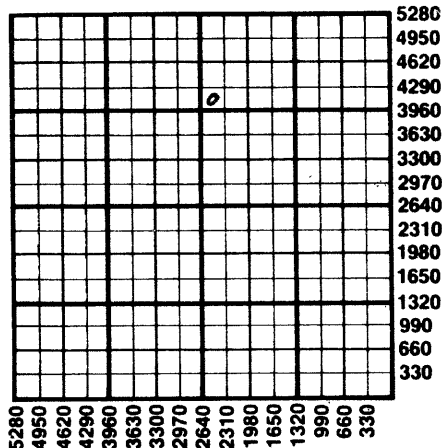

STATE CORPORATION COMMISSION

JAN 29 1986

CONSERVATION DIVISION

State Corporation Commission of Kansas

Conservation Division

200 Colorado Derby Building

Wichita, Kansas 67202

(316) 263-3238