CARD MUST BE TYPED

State of Kansas

NOTICE OF INTENTION TO DRILL

(see rules on reverse side)

CARD MUST BE SIGNED

Starting Date: SEPT. 10 1984
month day year

API Number 15- 059-23,673-00-00

OPERATOR: License # 7187
Name E.D. MAUSLEIN
Address 1008 Cedar Hills Dr.
City/State/Zip Olathe, Kansas 66061
Contact Person E.D. Mauslein
Phone 913 764 3199

CONTRACTOR: License # 6084
Name McMullin Well Service
City/State Wellsville, Kansas 66092

Well Drilled For:		Well Class:	Type Equipment:
[X] Oil	[ ] Swd	[X] Infield	[X] Mud Rotary
[ ] Gas	[ ] Inj	[ ] Pool Ext.	[ ] Air Rotary
[ ] OWWO	[ ] Expl	[ ] Wildcat	[ ] Cable

If OWWO: old well info as follows:
Operator
Well Name
Comp Date Old Total Depth

Projected Total Depth 710 feet
Projected Formation at TD 2nd squirrl
Expected Producing Formations 1st squirl

S½ S½ SW ~~Franklin~~ (location) Sec 9 Twp 16 S, Rge 21 [X] East [ ] West

465 Ft North from Southeast Corner of Section
3960 Ft West from Southeast Corner of Section
(Note: Locate well on Section Plat on reverse side)

Nearest lease or unit boundary line 465 feet.
County Franklin
Lease Name Mauslein Fee Well# 14-A
Domestic well within 330 feet: [ ] yes [X] no
Municipal well within one mile: [ ] yes [X] no

Depth to Bottom of fresh water 20 feet
Lowest usable water formation 250
Depth to Bottom of usable water 250 feet
Surface pipe by Alternate: 1 [ ] 2 [X]
Surface pipe to be set 20 feet
Conductor pipe if any required feet
Ground surface elevation feet MSL
This Authorization Expires 3-2-85
Approved By 8-30-84

I certify that we will comply with K.S.A. 55-101, et seq., plus eventually plugging hole to K.C.C. specifications.

Date Aug. 27, 84 Signature of Operator or Agent E.D. Mauslein Title owner - operator

Form C-1 4/84

MHC/LUDHE 8/30/84

Must be filed with the K.C.C. five (5) days prior to commencing well
This card void if drilling not started within six (6) months of date received by K.C.C.

A Regular Section of Land
1 Mile = 5,280 Ft.

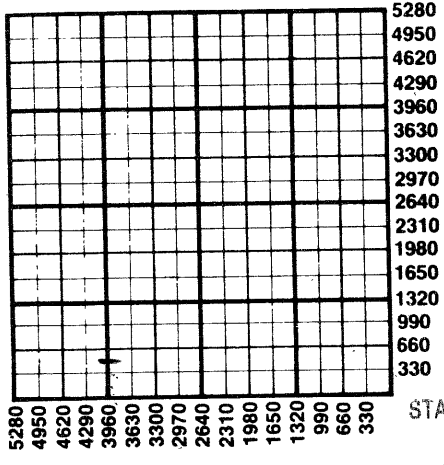

Important procedures to follow:

1. Notify District office before setting surface casing.
2. Set surface casing by circulating cement to the top.
3. File completion forms ACO-1 with K.C.C. within 90 days of well completion, following instructions on ACO-1, side 1, and including copies of wireline logs.
4. Notify District office 48 hours prior to old well workover or re-entry.
5. Prior to plugging, prepare a plugging plan, then obtain agreement from the appropriate district office for an approved plugging plan.
6. Submit plugging report (CP-4) to K.C.C. after plugging is completed.
7. Obtain an approved injection docket number before disposing of salt water.
8. Notify K.C.C. within 10 days when injection commences or terminates.
9. If an alternate 2 completion, cement in the production pipe from below any usable water to surface within 120 days of spud date.

RECEIVED
STATE CORPORATION COMMISSION

8-30-84

AUG 30 1984
CONSERVATION DIVISION
Wichita, Kansas

State Corporation Commission of Kansas
Conservation Division
200 Colorado Derby Building
Wichita, Kansas 67202
(316) 263-3238