

CARD MUST BE TYPED

State of Kansas

CARD MUST BE SIGNED

NOTICE OF INTENTION TO DRILL

(see rules on reverse side)

Expected Spud Date... Sept. 15 1987
month day year

API Number 15- 059-24,263-0000

OPERATOR: License # 7187

S. 1 W. 1/2 Sec. 9 Twp. 16 S, Rg. 21 East West

Name Ernest D. Mauslein

Address 1008 Cedar Hills Dr.

City/State/Zip Olathe, Kansas 66061

Contact Person Ernest D. Mauslein

Phone 913-764-3199

2145
4650
Ft. from South Line of Section
Ft. from East Line of Section

(Note: Locate well on Section Plat on reverse side)

Nearest lease or unit boundary line 495 feet

County Franklin

Lease Name Mauslein Fee Well # 19-a

CONTRACTOR: License # 6084

Name McMullin Well Service

City/State Wellsville, Kansas

Ground surface elevation feet MSL

Domestic well within 330 feet: yes no

Municipal well within one mile: yes no

Well Drilled For: Well Class: Type Equipment:

Oil Storage Infield Mud Rotary

Gas Inj Pool Ext. Air Rotary

OWWO Expl Wildcat Cable

Depth to bottom of fresh water 20 Ft.

Depth to bottom of usable water 200 Ft.

Surface pipe by Alternate: 1 2

If OWWO: old well info as follows:

Surface pipe planned to be set 20 Ft.

Conductor pipe required

Projected Total Depth 725 Ft. feet

Formation Squirrli

Operator

Well Name

Comp Date Old Total Depth

I certify that well will comply with K.S.A. 55-101, et seq., plus eventually plugging hole to KCC specifications.

Date 8-21-87 Signature of Operator or Agent Ernest D. Mauslein

Title Owner-Operator

For KCC Use:

Conductor Pipe Required feet; Minimum Surface Pipe Required 200 feet per Alt. Y (2)


This Authorization Expires 2-27-88 Approved By Jan 8-27-87

Must be filed with the K.C.C. five (5) days prior to commencing well
 This card void if drilling not started within six (6) months of date received by K.C.C.

Important procedures to follow:

1. Notify District office before setting surface casing.
2. Set surface casing by circulating cement to the top.
3. File completion forms ACO-1 with K.C.C. within 120 days of well spud date, following instructions on ACO-1, side 1, and including copies of wireline logs.
4. Notify District office 48 hours prior to old well workover or re-entry.
5. Prior to filing Intent, prepare a proposed plugging plan in case well is D & A, then obtain approval of plan when calling district office prior to setting surface pipe.
6. Submit plugging report (CP-4) to K.C.C. after plugging is completed.

A Regular Section of Land
1 Mile = 5,280 Ft.

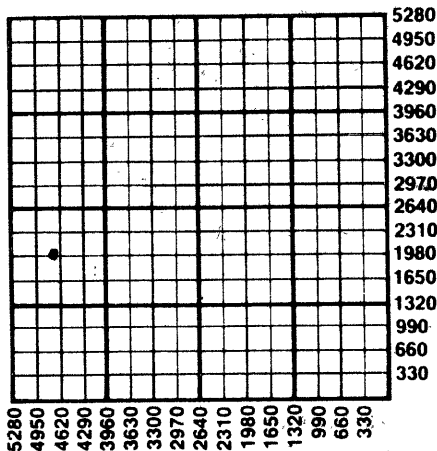

RECEIVED
 STATE CORPORATE COMMISSION

AUG 8 7 1987

CONSERVATION DIVISION
 Wichita, Kansas

7. Obtain an approved injection docket number before disposing of salt water.

8. Notify K.C.C. within 10 days when injection commences or terminates.

9. If an alternate 2 completion, cement in the production pipe from below any usable water to surface within 120 days of spud date.

8-27-87

State Corporation Commission of Kansas
 Conservation Division
 200 Colorado Derby Building
 Wichita, Kansas 67202-1212
 (316) 263-3238