

**CARD MUST BE SIGNED**

(see rules on reverse side)

API Number 15- 003-22,681-00-00

NE SW SW Sec. 35. Twp. 20. S, Rg. 19... X East  
— West

.....1150..... Ft. from South Line of Section

4400 Ft. from East Line of Section

(Note: Locate well on Section Plat on reverse side)

(Note: Locate well on Section Plat on reverse side)

Nearest lease or unit boundary line .....1.70.....feet

County.....Anderson.....

Lease Name.....Kane..... Well #..7.....

Ground surface elevation ... na ..... feet MSI

Domestic well within 330 feet: ☐ yes ☒ no

Domestic well within 330 feet: ☐ yes ☒ no

**Municipal well within one mile:** \_\_\_\_\_yes ☒no

Surface pipe by Alternate: 1 2 X

Depth to bottom of fresh water.....20.....

Depth to bottom of usable water ..... 125 .....

**Surface pipe planned to be set** ..... 20 .....

**Projected Total Depth** .....8.50.....feet

**Formation**.....Squirrel.....

by plugging hole to KCC specifications. 2 DONE

Recd for KONE

**For KCC Use:**

Conductor Pipe Required .....feet; Minimum Surface Pipe Required .....feet per Alt. 1 2

This Authorization Expires 3-12-86 Approved By 9-12-85 *[Signature]*

Must be filed with the K.C.C. five (5) days prior to commencing well  
This card void if drilling not started within six (6) months of date received by K.C.C.


9-12-85

**Important procedures to follow:**

RECEIVED  
STATE CORPORATION COMMISSION

A Regular Section of Land  
1 Mile = 5,280 Ft.

SEP 12 1985  
CONSERVATION DIVISION  
Wichita, Kansas

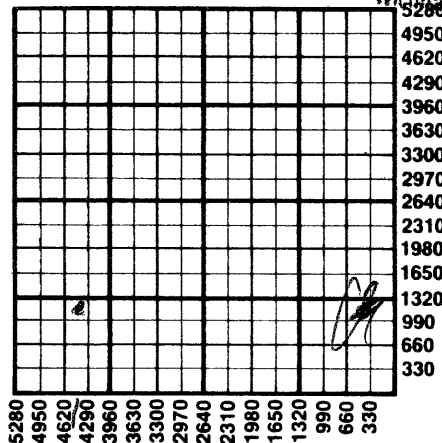

1. Notify District office before setting surface casing.
2. Set surface casing by circulating cement to the top.
3. File completion forms ACO-1 with K.C.C. within 90 days of well completion, following instructions on ACO-1, side 1, and including copies of wireline logs.
4. Notify District office 48 hours prior to old well workover or re-entry.
5. Prior to filing Intent, prepare a proposed plugging plan in case well is D & A, then obtain approval of plan when calling district office prior to setting surface pipe.
6. Submit plugging report (CP-4) to K.C.C. after plugging is completed.
7. Obtain an approved injection docket number before disposing of salt water.
8. Notify K.C.C. within 10 days when injection commences or terminates.
9. If an alternate 2 completion, cement in the production pipe from below any usable water to surface within 120 days of spud date.

State Corporation Commission of Kansas  
Conservation Division  
200 Colorado Derby Building  
Wichita, Kansas 67202  
(316) 263-3238