

CARD MUST BE TYPED

State of Kansas  
NOTICE OF INTENTION TO DRILL  
(see rules on reverse side)

CARD MUST BE SIGNED

Starting Date: November 9, 1985  
month day year

API Number 15- 059-24,099-00-00

OPERATOR: License # 5959

SW NE SW Sec 32 Twp 16 S, Rge 21  East  
(location)  West

Name Rader Oil Co.

Address R. R. #1

City/State/Zip Budora, Kansas 66025

Contact Person Richard Rader

Phone 883-2885

1810 Ft North from Southeast Corner of Section

3365 Ft West from Southeast Corner of Section

(Note: Locate well on Section Plat on reverse side)

CONTRACTOR: License # 5820

Nearest lease or unit boundary line 170 feet.

County Franklin

Lease Name Smith Well# 8

Name Kent Drilling Co.

City/State Garnett, Kansas 66030

Domestic well within 330 feet:  yes  no

Municipal well within one mile:  yes  no

Well Drilled For: Well Class: Type Equipment:

- Oil  Swd  Infield  Mud Rotary
- Gas  Inj  Pool Ext.  Air Rotary
- OWWO  Expl  Wildcat  Cable

Depth to Bottom of fresh water none ~ 20 feet

Lowest usable water formation none ~ 200

Depth to Bottom of usable water 200 feet

Surface pipe by Alternate: 1  2

Surface pipe to be set 20 feet

Conductor pipe if any required 0 feet

Ground surface elevation 950 feet MSL

This Authorization Expires 5-7-86

Approved By 11-7-85

If OWWO: old well info as follows:

Operator .....

Well Name .....

Comp Date ..... Old Total Depth .....

Projected Total Depth 700 feet

Projected Formation at TD Squirrel

Expected Producing Formations .....

I certify that we will comply with K.S.A. 55-101, et seq., plus eventually plugging hole to K.C.C. specifications.

Date Nov. 4, 1985 Signature of Operator or Agent

*Richard Rader*


Title Owner

*RCA/Kent*

Must be filed with the K.C.C. five (5) days prior to commencing well  
This card void if drilling not started within six (6) months of date received by K.C.C.

**Important procedures to follow :**

**A Regular Section of Land**  
**1 Mile = 5,280 Ft.**

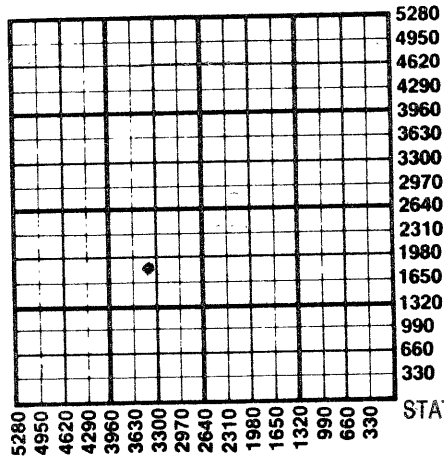

1. Notify District office before setting surface casing.
2. Set surface casing by circulating cement to the top.
3. File completion forms ACO-1 with K.C.C. within 90 days of well completion, following instructions on ACO-1, side 1, and including copies of wireline logs.
4. Notify District office 48 hours prior to old well workover or re-entry.
5. Prior to plugging, prepare a plugging plan, then obtain agreement from the appropriate district office for an approved plugging plan.
6. Submit plugging report (CP-4) to K.C.C. after plugging is completed.
7. Obtain an approved injection docket number before disposing of salt water.
8. Notify K.C.C. within 10 days when injection commences or terminates.
9. If an alternate 2 completion, cement in the production pipe from below any usable water to surface within 120 days of spud date.

RECEIVED  
STATE CORPORATION COMMISSION

State Corporation Commission of Kansas  
Conservation Division  
200 Colorado Derby Building  
Wichita, Kansas 67202  
(316) 263-3238

NOV 7 1985

CONSERVATION DIVISION  
Wichita, Kansas

11-7-85