

CARD MUST BE TYPED

State of Kansas

CARD MUST BE SIGNED

NOTICE OF INTENTION TO DRILL

(see rules on reverse side)

Expected Spud Date. May 7 1987
month day yearOPERATOR: License # 5959Name Rader Oil Co.Address R. R. #1City/State/Zip Eudora, Kansas 66025Contact Person Richard RaderPhone 913-883-2885CONTRACTOR: License # 5820Name Kent Drilling Co.City/State Garnett, Kansas 66032

Well Drilled For: Well Class: Type Equipment:

☒ Oil ☐ Storage ☒ Infield ☒ Mud Rotary☐ Gas ☐ Inj ☐ Pool Ext. ☐ Air Rotary☐ OWWO ☐ Expl ☐ Wildcat ☐ Cable

If OWWO: old well info as follows:

Operator

Well Name

Comp Date Old Total Depth

I certify that well will comply with K.S.A. 55-101, et seq., plus eventually plugging hole to KCC specifications.

Date April 29, 87 Signature of Operator or Agent Richard Rader Title Owner

For KCC Use:

Conductor Pipe Required feet; Minimum Surface Pipe Required 20 feet per Alt. # 2This Authorization Expires 11-4-87 Approved By 5-4-87API Number 15— 059-24,225-00-00SW SE NW Sec. 32 Twp. 16 S, Rg. 21 ☒ East2700 Ft. from South Line of Section3390 Ft. from East Line of Section

(Note: Locate well on Section Plat on reverse side)

Nearest lease or unit boundary line 720 feetCounty FranklinLease Name Garrett Well # 20Ground surface elevation 920 feet MSLDomestic well within 330 feet: ☐ yes ☒ noMunicipal well within one mile: ☐ yes ☒ no

Depth to bottom of fresh water.

Depth to bottom of usable water 200Surface pipe by Alternate: 21' 1 ☐ 2 ☒Surface pipe planned to be set 0

Conductor pipe required


Projected Total Depth 700' feetFormation Squirrel

Must be filed with the K.C.C. five (5) days prior to commencing well
This card void if drilling not started within six (6) months of date received by K.C.C.

Important procedures to follow:

1. Notify District office before setting surface casing.
2. Set surface casing by circulating cement to the top.
3. File completion forms ACO-1 with K.C.C. within 120 days of well spud date, following instructions on ACO-1, side 1, and including copies of wireline logs.
4. Notify District office 48 hours prior to old well workover or re-entry.
5. Prior to filing Intent, prepare a proposed plugging plan in case well is D & A, then obtain approval of plan when calling district office prior to setting surface pipe.
6. Submit plugging report (CP-4) to K.C.C. after plugging is completed.
7. Obtain an approved injection docket number before disposing of salt water.
8. Notify K.C.C. within 10 days when injection commences or terminates.
9. If an alternate 2 completion, cement in the production pipe from below any usable water to surface within 120 days of spud date.

A Regular Section of Land
1 Mile = 5,280 Ft.

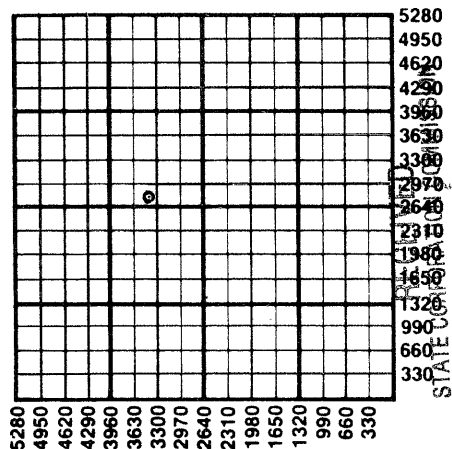

MAY 4 10:07

CONSERVATION DIVISION
Wichita, Kansas

5-4-87

State Corporation Commission of Kansas
Conservation Division
200 Colorado Derby Building
Wichita, Kansas 67202-1212
(316) 263-3238