

CARD MUST BE TYPED

State of Kansas
NOTICE OF INTENTION TO DRILL

CARD MUST BE SIGNED

(see rules on reverse side)

Starting Date: Aug 13, 1985
month day year

API Number 15- 121-26,630-00-00

9233 3:50

East

OPERATOR: License # APP. SW. SE. NE ... Sec 2 ... Twp 17 ... S, Rge 23 ... West

Name Midland Enterprises, Inc.

(location)

Address 935 Sunset

2755 Ft North from Southeast Corner of Section

City/State/Zip Lawrence, KS 66044

.818 Ft West from Southeast Corner of Section

Contact Person Jonathan Garrett

(Note: Locate well on Section Plat on reverse side)

Phone 913 841 6219

Nearest lease or unit boundary line 818 feet.

CONTRACTOR: License # 6807

County Miami

Name Oil Drillers & Dev. Inc.

Lease Name Crawford Well# 3-85

City/State Topeka, Ks 66614

Domestic well within 330 feet : yes no

Well Drilled For: Well Class: Type Equipment:

Municipal well within one mile : yes no

Oil Swd Infield Mud Rotary

Depth to Bottom of fresh water 200-2100 feet

Gas Inj Pool Ext. Air Rotary

Lowest usable water formation Kansas City Group

OWWO Expl Wildcat Cable

Depth to Bottom of usable water 250-200 feet

If OWWO: old well info as follows:

Surface pipe by Alternate : 1 2

Operator

Surface pipe to be set 20 feet

Well Name

Conductor pipe if any required feet

Comp Date Old Total Depth

Ground surface elevation feet MSL

Projected Total Depth 750 feet

This Authorization Expires 2-12-86

Projected Formation at TD

Approved By 8-12-85

Expected Producing Formations

I certify that we will comply with K.S.A. 55-101, et seq., plus eventually plugging hole to K.C.C. specifications.

Date 8/12/85 Signature of Operator or Agent Edwina Johnson Title

as agent

KEA FOR K.D.A.E

RECEIVED
STATE CORPORATION COMMISSION

Must be filed with the K.C.C. five (5) days prior to commencing well
This card void if drilling not started within six (6) months of date received by K.C.C.

AUG 12 1985


CONSERVATION DIVISION
Regular Section of Land-
1 Mile = 5,280 Ft.

RECEIVED
STATE CORPORATION COMMISSION

07-26-85
AUG 26 1985

Important procedures to follow:

1. Notify District office before setting surface casing.
2. Set surface casing by circulating cement to the top.
3. File completion forms ACO-1 with K.C.C. within 90 days of well completion, following instructions on ACO-1, side 1, and including copies of wireline logs.
4. Notify District office 48 hours prior to old well workover or re-entry.
5. Prior to plugging, prepare a plugging plan, then obtain agreement from the appropriate district office for an approved plugging plan.
6. Submit plugging report (CP-4) to K.C.C. after plugging is completed.
7. Obtain an approved injection docket number before disposing of salt water.
8. Notify K.C.C. within 10 days when injection commences or terminates.
9. If an alternate 2 completion, cement in the production pipe from below any usable water to surface within 120 days of spud date.

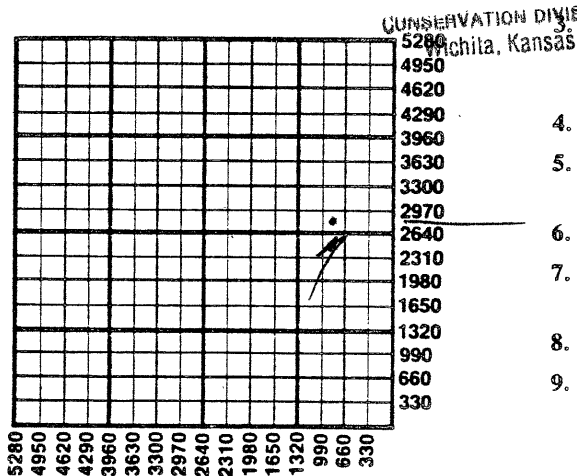

State Corporation Commission of Kansas
Conservation Division
200 Colorado Derby Building
Wichita, Kansas 67202
(316) 263-3238