

CARD MUST BE TYPED

State of Kansas  
**NOTICE OF INTENTION TO DRILL**  
(see rules on reverse side)

Collection  
CARD MUST BE SIGNED

Starting Date: ..... 1 ..... 18 ..... 85 .....  
month day year 2:50

OPERATOR: License # 7112  
Name Reusch Well Service  
Address 401 S. Main, Suite 11  
City/State/Zip Ottawa, KS 66067  
Contact Person Liz Reusch  
Phone 913 242-5733

CONTRACTOR: License # 8509  
Name Evans Energy Development, Inc.  
City/State Ottawa, KS

| Well Drilled For:                                                    | Well Class:                                 | Type Equipment:                                |
|----------------------------------------------------------------------|---------------------------------------------|------------------------------------------------|
| <input checked="" type="checkbox"/> Oil <input type="checkbox"/> Swd | <input checked="" type="checkbox"/> Infield | <input checked="" type="checkbox"/> Mud Rotary |
| <input type="checkbox"/> Gas <input type="checkbox"/> Inj            | <input type="checkbox"/> Pool Ext.          | <input type="checkbox"/> Air Rotary            |
| <input type="checkbox"/> OWWO <input type="checkbox"/> Expl          | <input type="checkbox"/> Wildcat            | <input type="checkbox"/> Cable                 |

If OWWO: old well info as follows:

Operator .....  
Well Name .....  
Comp Date ..... Old Total Depth .....  
Projected Total Depth 1000 ..... feet  
Projected Formation at TD .....  
Expected Producing Formations .....

I certify that we will comply with K.S.A. 55-101, et seq., plus eventually plugging hole to K.C.C. specifications.

Date 4/19/85 Signature of Operator or Agent

*Liz Reusch*

Title Office Manager

**CORRECTION**

API Number 15- 121-26,483-60-00

NE/4 Sec 17 Twp 17 S, Rge 23  
(location) ☒ East ☐ West

\* 3950 Ft North from Southeast Corner of Section  
2475 Ft West from Southeast Corner of Section  
(Note: Locate well on Section Plat on reverse side)

Nearest lease or unit boundary line 165 feet.

County Miami

Lease Name Plummer Well# 1

Domestic well within 330 feet: ☐ yes ☒ no

Municipal well within one mile: ☐ yes ☒ no

Depth to Bottom of fresh water 20 feet

Lowest usable water formation Kansas City Group

Depth to Bottom of usable water 200 feet

Surface pipe by Alternate: 1 ☐ 2 ☒

Surface pipe to be set 20 feet

Conductor pipe if any required feet

Ground surface elevation feet MSL

This Authorization Expires 7/17/85


Approved By 1/17/85 RC

*was 3960 FSL*

Must be filed with the K.C.C. five (5) days prior to commencing well  
This card void if drilling not started within six (6) months of date received by K.C.C.

**Important procedures to follow :**

**A Regular Section of Land  
1 Mile = 5,280 Ft.**

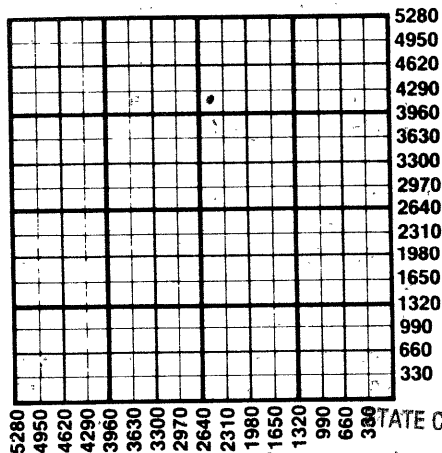

1. Notify District office before setting surface casing.
2. Set surface casing by circulating cement to the top.
3. File completion forms ACO-1 with K.C.C. within 90 days of well completion, following instructions on ACO-1, side 1, and including copies of wireline logs.
4. Notify District office 48 hours prior to old well workover or re-entry.
5. Prior to plugging, prepare a plugging plan, then obtain agreement from the appropriate district office for an approved plugging plan.
6. Submit plugging report (CP-4) to K.C.C. after plugging is completed.
7. Obtain an approved injection docket number before disposing of salt water.
8. Notify K.C.C. within 10 days when injection commences or terminates.
9. If an alternate 2 completion, cement in the production pipe from below any usable water to surface within 120 days of spud date.

RECEIVED

STATE CORPORATION COMMISSION

APR 29 1985

CONSERVATION DIVISION  
Wichita, Kansas

State Corporation Commission of Kansas  
Conservation Division  
200 Colorado Derby Building  
Wichita, Kansas 67202  
(316) 263-3238